

CODED

Fire Walkall
M H 12
5-68

MISSISSIPPI
BOARD OF WATER COMMISSIONERS
416 North State Street
Jackson, Mississippi 39201

WATER WELL DRILLERS LOG

Walkall
Ribe

5-70 1968 *Fitzgould well* firm name *Ribe* county well located
date well completed

LANDOWNER: *Prentiss Brack*

description of formations encountered

from to

RR 5 Tylertown, Miss
(mailing address)

<i>Red clay</i>	<i>0</i>	<i>15</i>
<i>Red sand</i>	<i>15</i>	<i>60</i>
<i>Red gravel</i>	<i>60</i>	<i>65</i>
<i>Blue clay</i>	<i>65</i>	<i>125</i>
<i>Fine sand</i>	<i>125</i>	<i>175</i>
<i>Coarse sand</i>	<i>175</i>	<i>186</i>

WELL LOCATION: *CORRECT*

sec. *20* T. *1* N. R. *10* E
8 miles *SE* of *Progress*
(distance) (direction) (nearest town)

WELL PURPOSE: *Home*
(home, irrigation, municipal, industrial)

WELL COMPLETION DATA:

- (1) diameter (inches) *4*
- (2) total depth (feet) *186*
- (3) static water level (feet) *60* below top of ground.
- (4) casing *4* (material), *180* (depth)
4 (size) if telescope see back.
- (5) screen *6* (length), *180* (depth to top)
4 (size), *plastic* (material)
- (6) pump *7* (HP), *7* (yield gpm)
also (type power)
- (7) electric log *no* (yes or no)
(organization running log)
- (8) how well bottom plugged *wood peg*


MISSISSIPPI
MICH. BD. OF
WATER CONTROL

MISSISSIPPI
BOARD OF
WATER CONTROL

DRILLERS REMARKS:

If well telescopes please sketch and show depths.

GROUND LEVEL

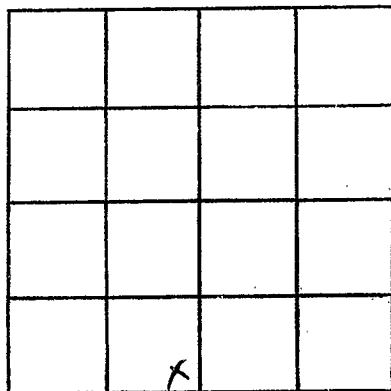

SECTION 20

Please indicate well location X.

ADDITIONAL INFORMATION

If more than one screen, show locations of each on sketch.