

WALTHALL

H 13

1-20-60000

WATER WELL DRILLERS LOG

H 300

Date: 1-20, 1961, Driller: W J Fitzgerald County ~~Walthall~~ Walthall

(Name)

- (1) Owner of Land: Hubert McDaniel
(Name)
Lexie Town Rty
SE Corner (Address)
- (2) Location: SW 1/4, NE 1/4, Sec. 3 T1 R10
1 miles W of Lexie
(distance) (direction) (Nearest Town)
- (3) Topography: Hilly
(Hilly) (Flat) (Level)
- (4) Purpose of Well: House Use
(Domestic Irrigation
Municipal, Industrial, Other)


Description & Color of Materials Sand, Clay, Red Clay, Shell, etc.	Thick- ness Feet	Depth Feet
<u>Top soil & clay</u>	<u>0</u>	<u>15</u>
<u>Red sand & gravel</u>	<u>5</u>	<u>40</u>
<u>Red chalk</u>	<u>40</u>	<u>55</u>
<u>White sand</u>	<u>55</u>	<u>75</u>

Information upon completion of well:

- (1) Diameter 2 inches.
- (2) Total Depth 73 feet.
- (3) Water Level 45 feet below top of ground.
- (4) Cased to 68, Size 2
- (5) Screen: Size 1/4, Length 5
- (6) Were any formations sealed against pollution?
_____ yes, no.

CODED

If YES depth of formation _____
Why _____
Drillers Remarks: _____

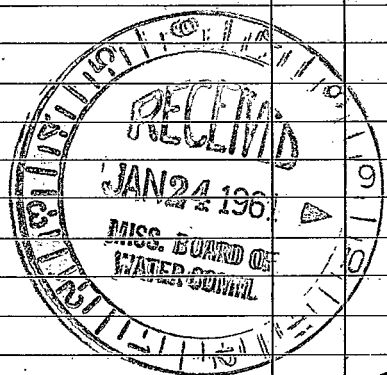

(Use Back Side)

Well No.

