

WALTHALL  
H-16  
8-21-71

MISSISSIPPI  
BOARD OF WATER COMMISSIONERS  
416 North State Street  
Jackson, Mississippi 39201

**CODED**

WATER WELL DRILLERS LOG

8-21 1971 Fitzgerald Well Co Walthall  
date well completed firm name county well located

| LANDOWNER:  | description of formations encountered | from      | to         |
|---|---------------------------------------|-----------|------------|
| <u>Tommy Hill</u>   |                                       |           |            |
| <u>P.R. Tylston</u><br>(mailing address)  | <u>Red sand</u>                       | <u>20</u> | <u>90</u>  |
| WELL LOCATION:  | <u>Concrete &amp; gravel</u>          | <u>90</u> | <u>107</u> |
| sec. <u>30</u> T. <u>1</u> N. <u>S</u> R. <u>10</u> E                               |                                       |           |            |
| <u>9</u> miles <u>SW</u> of <u>Tylston</u><br>(distance) (direction) (nearest town) |                                       |           |            |
| WELL PURPOSE: <u>Home</u><br>(home, irrigation, municipal, industrial)              |                                       |           |            |
| WELL COMPLETION DATA:   |                                       |           |            |
| (1) diameter (inches) <u>4</u>  |                                       |           |            |
| (2) total depth (feet) <u>107</u>   |                                       |           |            |
| (3) static water level (feet) <u>70</u> below above<br>top of ground.               |                                       |           |            |
| (4) casing <u>duct</u> , <u>99</u> ,<br>(material) (depth)                          |                                       |           |            |
| <u>4</u> if telescope see back.<br>(size)   |                                       |           |            |
| (5) screen <u>8</u> , <u>99</u><br>(length) (depth to top)                          |                                       |           |            |
| <u>4</u> , <u>duct</u><br>(size) (material)   |                                       |           |            |
| (6) pump <u>1/2</u> , <u>8</u><br>(HP) (yield gpm)                                  |                                       |           |            |
| <u>eli</u><br>(type power)  |                                       |           |            |
| (7) electric log <u>no</u><br>(yes or no)   |                                       |           |            |
| (organization running log)  |                                       |           |            |
| (8) how well bottom plugged <u>concrete</u>   |                                       |           |            |
| DRILLERS REMARKS:   |                                       |           |            |


**CODED**

SEP 15 1971

MISS. BD. OF  
WATER COMM.

If well telescopes please sketch and show depths.

GROUND LEVEL

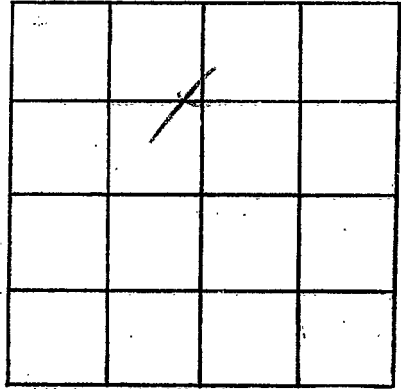

SECTION 3

Please indicate well location X.

ADDITIONAL INFORMATION

If more than one screen,  
show locations of each on sketch.