

WalThall

H-17

8-24-71

MISSISSIPPI
 BOARD OF WATER COMMISSIONERS
 416 North State Street
 Jackson, Mississippi 39201

WATER WELL DRILLERS LOG

CODED

8-24
date well completed

1971 *F. J. ...*
firm name

county well located

LANDOWNER:	description of formations encountered	from	to
<i>Mary Hillburn</i> <i>P.R. Tylston, Miss.</i> (mailing address)			
WELL LOCATION:			
sec. <i>12 T 1</i> <i>N</i> <i>S</i> R. <i>10 E</i> <i>E</i>			
<i>6</i> miles <i>S</i> of <i>Tylston</i> (distance) (direction) (nearest town)			
WELL PURPOSE:			
<i>Home</i> (home, irrigation, municipal, industrial)			
WELL COMPLETION DATA:			
(1) diameter (inches) <i>4</i>			
(2) total depth (feet) <i>96</i>			
(3) static water level (feet) <i>12</i> below above top of ground.			
(4) casing <i>plastic</i> , <i>90</i> (material) (depth)			
<i>4</i> if telescope see back. (size)			
(5) screen <i>6</i> , <i>90</i> (length) (depth to top)			
<i>4</i> , <i>plastic</i> (size) (material)			
(6) pump <i>1/2</i> , <i>5</i> (HP) (yield gpm)			
<i>al</i> (type power)			
(7) electric log <i>no</i> (yes or no)			
(organization running log)			
(8) how well bottom plugged <i>excellent plug</i>			
DRILLERS REMARKS:			


CODED

SEP 15 1971

MISS. BD. OF
WATER COMM.

If well telescopes please sketch and show depths.

GROUND LEVEL

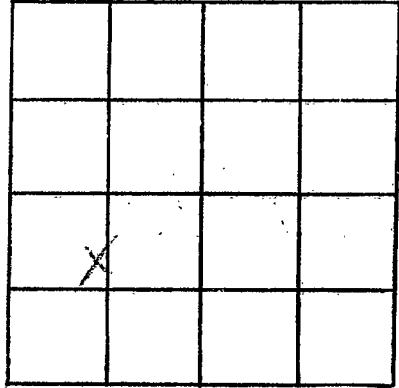

SECTION 12

Please indicate well location X.

ADDITIONAL INFORMATION

If more than one screen, show locations of each on sketch.