

WALTHALL MISSISSIPPI BOARD OF WATER COMMISSIONERS

H 19

6-3-66 **CODED**

WATER WELL DRILLERS LOG

Date: 6/3, 1966, Driller: T. B. Andrews County Walthall
 (Name)

(1) Owner of Land: O. B. Davis
 (Name)
Tyke town, Miss
 (Address)

(2) Location: 1/4, 1/4, Sec. 29 T 1 R 10,
9 miles S.W. of Tyke town
 (distance) (direction) (Nearest Town)

(3) Topography: Hilly
 (Hilly) (Flat) (Level)

(4) Purpose of Well: Domestic
 (Domestic Irrigation
 Municipal, Industrial, Other)

Description & Color of Materials Sand, Clay, Red Clay, Shell, etc.	Thick- ness Feet	Depth Feet
0' to 20' Red Clay		
20' to 70' Sand		
70' to 80' pea gravel		

Information upon completion of well:

(1) Diameter 4 inches.

(2) Total Depth 80 feet.

(3) Water Level 40 feet below top of ground.

(4) Cased to 80', Size 4"


(5) Screen: Size 4", Length 6"

(6) Were any formations sealed against pollution?
no.

If YES depth of formation _____
 Why _____

Drillers Remarks:
Plastic well

CODED

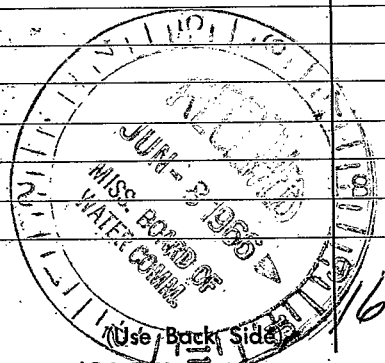

Well No. 19

