

MISSISSIPPI
 BOARD OF WATER COMMISSIONERS
 416 North State Street
 Jackson, Mississippi 39201

WATER WELL DRILLERS LOG

Walthall
 H21
 6-66

CODED

6-20 1966 Fitzgerald Water Well Service Walthall
 date well completed firm name county well located

LANDOWNER: Humphery Smith
Lexie, Miss.
 (mailing address)


Description of formations encountered	from	to
Top Soil + clay	0	20
Red Chalk	60	80
Heavy gravel	80	97

WELL LOCATION:
 sec 35 T 1 N 10 E
7 miles S-SE of Lexie
 (distance) (direction) (nearest town)

WELL PURPOSE: home
 (home, irrigation, municipal, industrial)

- WELL COMPLETION DATA:
- (1) diameter (inches) 4
 - (2) total depth (feet) 97
 - (3) static water level (feet) 75 below above top of ground.
 - (4) casing plastic, 67
 (material) (depth)
4" if telescope see back.
 (size)
 - (5) screen 81, 67
 (length) (depth to top)
4", plastic
 (size) (material)
 - (6) pump 1/2 Sub, 12
 (HP) (yield gpm)
elec
 (type power)
 - (7) electric log no
 (yes or no)
 (organization running log)
 - (8) how well bottom plugged Wood peg


CODED

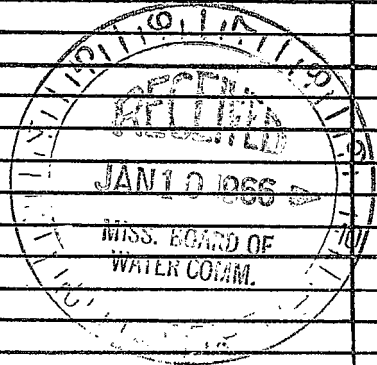

DRILLERS REMARKS:

If well telescopes please sketch and show depths.

GROUND LEVEL

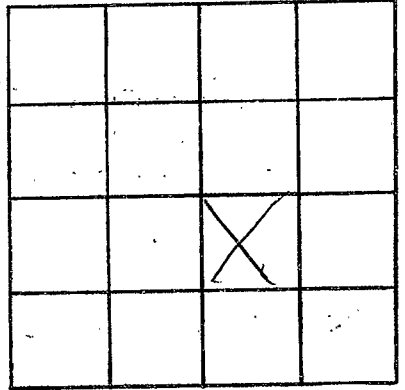

SECTION 385

Please indicate well location X.

ADDITIONAL INFORMATION

If more than one screen, show locations of each on sketch.