

Walthall  
 H 23  
 10-2-67  
 CODED

MISSISSIPPI  
 BOARD OF WATER COMMISSIONERS  
 416 North State Street  
 Jackson, Mississippi 39201

WATER WELL DRILLERS LOG

Oct. 2 1967 Ferniet-Elbert Brown Walthall  
 date well completed firm name county well located

LANDOWNER:  
Stanley Smith  
RT 6, Tylertown  
 (mailing address)


description of formations encountered	from	to
clay	0	15
sand + gravel	15	45
white clay	45	80
sand + gravel	80	100
gravel	100	108

WELL LOCATION:  
 sec. 10 T. 10 N. R. 10 E.  
4 miles SW of Tylertown  
 (distance) (direction) (nearest town)

WELL PURPOSE: Home  
 (home, irrigation, municipal, industrial)

- WELL COMPLETION DATA:
- (1) diameter (inches) 4"
  - (2) total depth (feet) 108'
  - (3) static water level (feet) \_\_\_\_\_ below/above top of ground.
  - (4) casing plastic, 108'  
 (material) (depth)  
4"  
 (size) if telescope see back.
  - (5) screen 5', 103'  
 (length) (depth to top)  
4", PLASTIC  
 (size) (material)
  - (6) pump 3/4 5  
 (HP) (yield gpm)  
Elect  
 (type power)
  - (7) electric log \_\_\_\_\_  
 (yes or no)  
 \_\_\_\_\_  
 (organization running log)
  - (8) how well bottom plugged W V

CODED

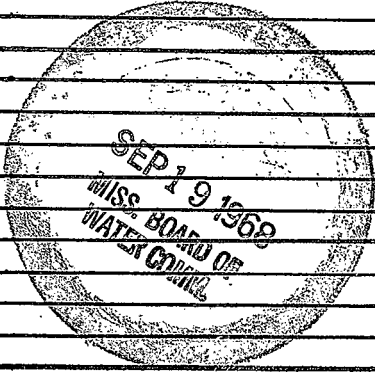

DRILLERS REMARKS: Get Pump

If well telescopes please sketch and show depths.

GROUND LEVEL

X			

SECTION 10

Please indicate well location X.

ADDITIONAL INFORMATION

If more than one screen, show locations of each on sketch.