

**MISSISSIPPI
BOARD OF WATER COMMISSIONERS**
416 North State Street
Jackson, Mississippi 39201

WATER WELL DRILLERS LOG

Walthall
H 24
7-19-69

CODED

July 19 1969 Jessie Albert Brown Walthall
date well completed firm name county well located

LANDOWNER:

Lawrence Holiday
Jylertown miss
(mailing address)

description of formations encountered

from to

<u>Red Clay</u>	<u>0</u>	<u>20</u>
<u>White Clay</u>	<u>20</u>	<u>40</u>
<u>sand & gravel</u>	<u>40</u>	<u>69</u>

WELL LOCATION:

sec. 18 T. 10 N. R. 10 E.
S. W. W.
6 miles SW of Lute
(distance) (direction) (nearest town)

WELL PURPOSE:


Home
(home, irrigation, municipal, industrial)

WELL COMPLETION DATA:

- (1) diameter (inches) 4"
- (2) total depth (feet) 69'
- (3) static water level (feet) 45' ^{below} _{above} top of ground.
- (4) casing plastic 69' (material) (depth)
4" (size) if telescope see back.
- (5) screen 5' (length) 64' (depth to top)
4" (size) plastic (material)
- (6) pump 3/4 (HP) 4 (yield gpm)
ELECT (type power)
- (7) electric log _____ (yes or no)

(organization running log)
- (8) how well bottom plugged W V

CODED

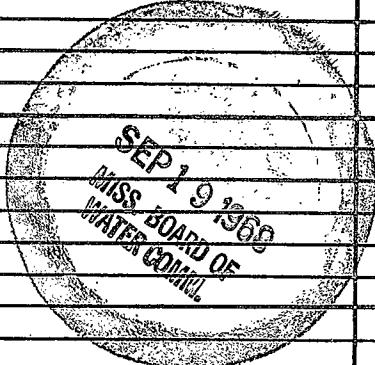

DRILLERS REMARKS:

JET PUMP

If well telescopes please sketch and show depths.

GROUND LEVEL

X			

SECTION 18

Please indicate well location X.

ADDITIONAL INFORMATION

If more than one screen, show locations of each on sketch.