

Walthall  
H 25  
4-67

**CODED**

MISSISSIPPI  
BOARD OF WATER COMMISSIONERS  
416 North State Street  
Jackson, Mississippi 39201

WATER WELL DRILLERS LOG

4/10 1967 Andy's Drilling Walthall  
date well completed firm name county well located

LANDOWNER: Mrs. Hope  
Broomfield Rt. 4  
Tylertown, Miss  
(mailing address)

description of formations encountered	from	to
<u>Chalk</u>	<u>0'</u>	<u>20'</u>
<u>Sand - gravel</u>	<u>20'</u>	<u>40'</u>
<u>Blue Clay</u>	<u>40'</u>	<u>120'</u>
<u>Sand</u>	<u>120'</u>	<u>158'</u>

WELL LOCATION:  
sec. 24 T 1 N R 9 E  
6 1/2 miles SW of Tylertown  
(distance) (direction) (nearest town)

WELL PURPOSE: Home  
(home, irrigation, municipal, industrial)

WELL COMPLETION DATA:

- (1) diameter (inches) 2"
- (2) total depth (feet) 158'
- (3) static water level (feet) 40' below top of ground.
- (4) casing galv. (153' depth)  
2" (size) if telescope see back.
- (5) screen 5' (153' depth to top)  
2" (rodless steel material) of what?
- (6) pump 3 (10 yield gpm)  
220 (type power)
- (7) electric log No (yes or no)  
(organization running log)
- (8) how well bottom plugged Jack  
Wash Valve


**CODED**



DRILLERS REMARKS:

If well telescopes please sketch and show depths.

GROUND LEVEL

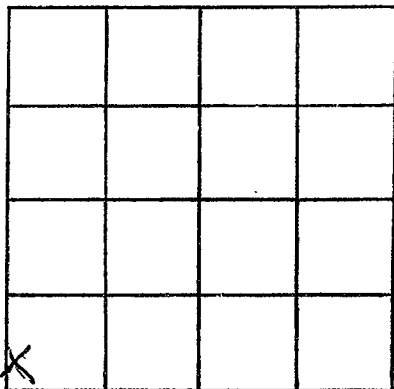

SECTION 24

Please indicate well location X.

ADDITIONAL INFORMATION

If more than one screen,  
show locations of each on sketch.