

Walthall  
H 26  
5-67

CODED

MISSISSIPPI  
BOARD OF WATER COMMISSIONERS  
416 North State Street  
Jackson, Mississippi 39201

WATER WELL DRILLERS LOG

May 27 1969 date well completed  
69 Fitzgerald Water Well firm name  
Walthall county well located

LANDOWNER: Mrs E V Tidwell  
Rt 6, Tyler Town  
(mailing address)

description of formations encountered	from	to
top soil & clay	0	18
dark sand & gravel	18	34
Rock	34	35
White chalk	35	42
fine sand	42	75
parallel sand	75	82
Rock	82	02

WELL LOCATION:  
sec 32 T 7 N R 10 E  
10 miles SW of Tyler town  
(distance) (direction) (nearest town)

WELL PURPOSE: home  
(home, irrigation, municipal, industrial)

WELL COMPLETION DATA:

(1) diameter (inches) 4 3/8

(2) total depth (feet) 82

(3) static water level (feet) 30 below top of ground.

(4) casing plastic 77 (material) (depth)  
4 (size) if telescope see back.

(5) screen 61 77 (length) (depth to top)  
4 plastic (size) (material)

(6) pump 1/2 HP 8 (type) (yield gpm)  
Elec (type power)

(7) electric log NO (yes or no)  
(organization running log)

(8) how well bottom plugged wood peg


CODED



DRILLERS REMARKS:

If well telescopes please sketch and show depths.

GROUND LEVEL

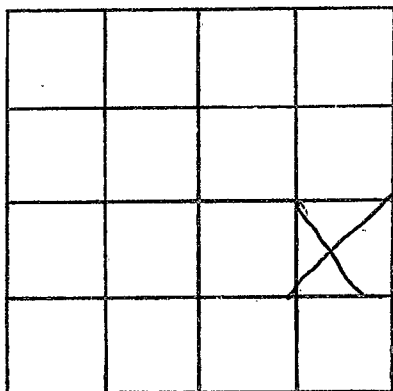

SECTION 39

Please indicate well location X.

ADDITIONAL INFORMATION

If more than one screen, show locations of each on sketch.