

Walthall
H27
6-67

MISSISSIPPI
BOARD OF WATER COMMISSIONERS
416 North State Street
Jackson, Mississippi 39201

WATER WELL DRILLERS LOG

June 10 1967
date well completed firm name county well located

COPIED

LANDOWNER: Mrs. Edgar Holmes
R6 - Tylertown Miss

description of formations encountered	from	to
Red Chalk	0	25
Fr Sand	25	25
White Chalk	25	140
White Sand	140	160
Medium Sand	160	196
Coarse Sand & gravel	196	220

(mailing address)

WELL LOCATION:
sec. 13 T. 1 N. R. 10 E
S W
6 miles SE of Tylertown
(distance) (direction) (nearest town)

WELL PURPOSE: home
(home, irrigation, municipal, industrial)

WELL COMPLETION DATA:

- (1) diameter (inches) 4
- (2) total depth (feet) 220
- (3) static water level (feet) 110 below above top of ground.
- (4) casing plastic 2 1/2 (material) (depth)
- (5) screen 4" if telescope see back. 8' 2 1/2 (length) (depth to top)
- (6) pump 1 1/2 HP 10 (HP) (yield gpm)
- (7) electric log Eloc (type power)
- (8) how well bottom plugged Wood peg


COPIED



DRILLERS REMARKS:

If well telescopes please sketch and show depths.

GROUND LEVEL

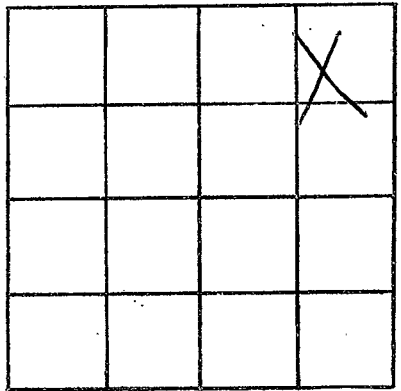

SECTION 13

Please indicate well location X.

ADDITIONAL INFORMATION

If more than one screen, show locations of each on sketch.