

Walthall  
H 28  
7-67

CODED

MISSISSIPPI  
BOARD OF WATER COMMISSIONERS  
416 North State Street  
Jackson, Mississippi 39201

WATER WELL DRILLERS LOG

7/6/67 19 Ardy's Drilling Walthall  
date well completed firm name county well located

LANDOWNER: Clara Beunfield  
et. 7 Tipton town, Miss  
39667  
(mailing address)


description of formations encountered	from	to
Red Clay	0'	20'
Sand	20'	40'
gravel	40'	60'
Chalk	60'	77'
Sand / gravel	77'	97'

WELL LOCATION:  
sec. 4 T 1 N R 10 E  
5 miles SE of Tipton town  
(distance) (direction) (nearest town)

WELL PURPOSE: Home  
(home, irrigation, municipal, industrial)

- WELL COMPLETION DATA:
- (1) diameter (inches) 4"
  - (2) total depth (feet) 97'
  - (3) static water level (feet) 70' below top of ground.
  - (4) casing P.V.C. 91'  
(material) (depth)  
4" if telescope see back.  
(size)
  - (5) screen 6' 97'  
(length) (depth to top)  
4" P.V.C.  
(size) (material)
  - (6) pump 1 10  
(HP) (yield gpm)  
220  
(type power)
  - (7) electric log NO  
(yes or no)  
  
(organization running log)
  - (8) how well bottom plugged Back Wash Valve


CODED

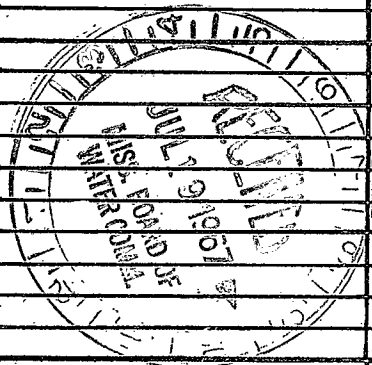

DRILLERS REMARKS:

If well telescopes please sketch and show depths.

GROUND LEVEL

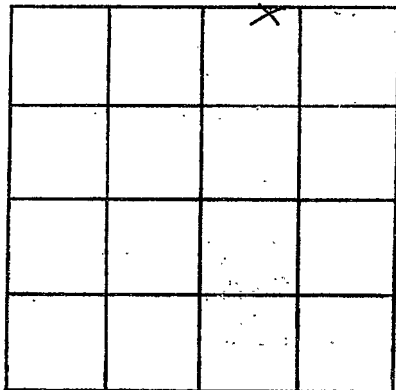

SECTION 4

Please indicate well location X.

ADDITIONAL INFORMATION

If more than one screen,  
show locations of each on sketch.