

Walthall
H 29
12-67

MISSISSIPPI
BOARD OF WATER COMMISSIONERS
416 North State Street
Jackson, Mississippi 39201

WATER WELL DRILLERS LOG

12-8 1967 Pilgrimage Water Well Walthall
date well completed firm name county well located

LANDOWNER: James McCaffrey
Tylertown Miss Rt 1
(mailing address)


WELL LOCATION:
sec. 20 T. 1 N. R. 10 E.
7 miles SW of Tylertown
(distance) (direction) (nearest town)

WELL PURPOSE: home
(home, irrigation, municipal, industrial)

- WELL COMPLETION DATA:
- (1) diameter (inches) 4
 - (2) total depth (feet) 145
 - (3) static water level (feet) 60 below/above top of ground.
 - (4) casing plastic 89
(material) (depth)
4 if telescope see back.
(size)
 - (5) screen 4' 89
(length) (depth to top)
4 sch 40
(size) (material)
 - (6) pump 1 sub 30
(HP) (yield gpm)
elec
(type power)
 - (7) electric log no
(yes or no)
Wood peg
(organization running log)
 - (8) how well bottom plugged

description of formations encountered	from	to
np soil & clay	0	15
sand	15	50
gravel	50	70
soupy sand	70	83
coarse sand & gravel	83	95
Chalk	95	

CODED

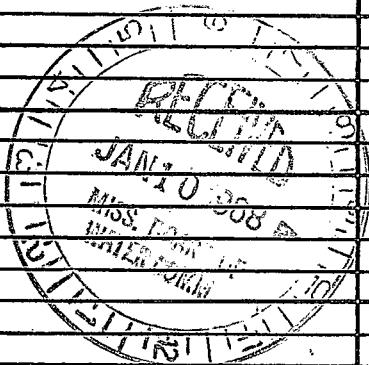

DRILLERS REMARKS:

If well telescopes please sketch and show depths.

GROUND LEVEL

X			

SECTION 20

Please indicate well location X.

ADDITIONAL INFORMATION

If more than one screen, show locations of each on sketch.