

Walthall
 H 30
 1-68 CODED

MISSISSIPPI
 BOARD OF WATER COMMISSIONERS
 416 North State Street
 Jackson, Mississippi 39201

WATER WELL DRILLERS LOG

1-78 1968 Edward Walthall Walthall
 date well completed firm name county well located

LANDOWNER: debie Baptist Church
Walter Town PT Miss
 (mailing address)

description of formations encountered	from	to
top soil	0	4
Chalk	4	22
gravel	22	24
Chalk	24	62
Sand	62	80
Blue Chalk	80	140
Blue Sand	140	200
Coarse Sand	200	245
Paravel -	245	255

WELL LOCATION:
 sec 2 T 1 N 10 E
4 miles 50 W of Waltertown
 (distance) (direction) (nearest town)

WELL PURPOSE: Municipal
 (home, irrigation, municipal, industrial)

WELL COMPLETION DATA:

(1) diameter (inches) 4

(2) total depth (feet) 255

(3) static water level (feet) 2 below above top of ground.

(4) casing plastic 249
 (material) (depth)
4 if telescope see back.
 (size)


(5) screen 6' 249
 (length) (depth to top)
4 plastic
 (size) (material)

(6) pump — —
 (HP) (yield gpm)
Elec
 (type power)

(7) electric log No
 (yes or no)

(8) how well bottom plugged plugged
 (organization running log)


CODED

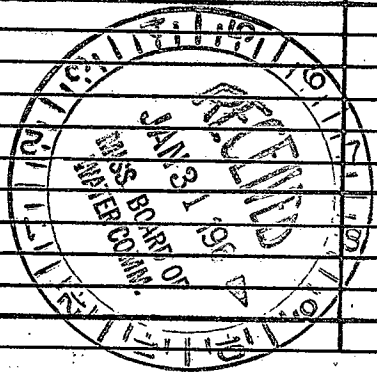

DRILLERS REMARKS:

If well telescopes please sketch and show depths.

GROUND LEVEL

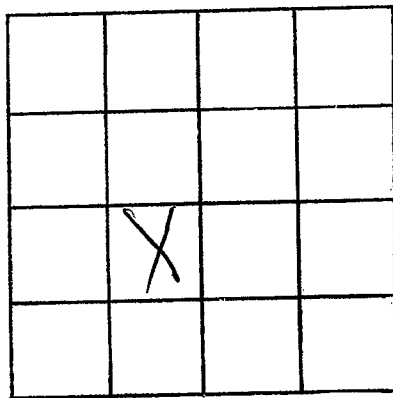

SECTION 2

Please indicate well location X.

ADDITIONAL INFORMATION

If more than one screen, show locations of each on sketch.