

**MISSISSIPPI
BOARD OF WATER COMMISSIONERS**
416 North State Street
Jackson, Mississippi 39201

WATER WELL DRILLERS LOG

Walthall
H 33
6-15-67

CODED

6-15 1967 Fleming & Hunt Brown Walthall
date well completed firm name county well located

LANDOWNER:

Harold Broef

Dyersburg Miss
(mailing address)

description of formations encountered

	from	to
<u>Red clay</u>	<u>0</u>	<u>30</u>
<u>Sand & gravel</u>	<u>30</u>	<u>70</u>
<u>White clay</u>	<u>70</u>	<u>83</u>
<u>Sand & gravel</u>	<u>83</u>	<u>94</u>

WELL LOCATION:

sec. 19 T. 1N R. 10E
8 miles SW of Dyersburg
(distance) (direction) (nearest town)

WELL PURPOSE: None
(home, irrigation, municipal, industrial)

WELL COMPLETION DATA:

- (1) diameter (inches) 4
(2) total depth (feet) 94
(3) static water level (feet) 80 below top of ground.
(4) casing Plastic, 89
(material) (depth)

 if telescope see back.
(size)

- (5) screen 4, Plastic
(length) (depth to top)
(size) (material)

- (6) pump 3/4 hp, 10
(HP) (yield gpm)
Elec
(type power)


- (7) electric log No
(yes or no)

(organization running log)

- (8) how well bottom plugged W V


DRILLERS REMARKS:

CODED

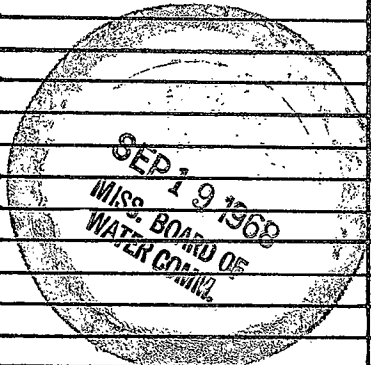

If well telescopes please sketch and show depths.

GROUND LEVEL

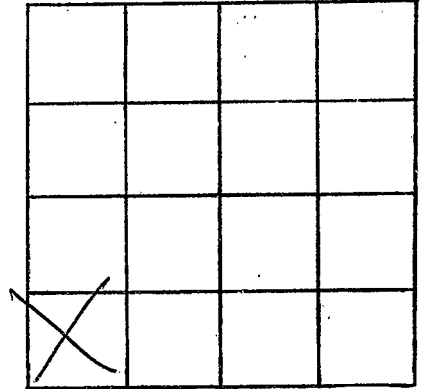

SECTION 19

Please indicate well location X.

ADDITIONAL INFORMATION

If more than one screen,
show locations of each on sketch.