

Walthall  
H34  
3-23-67

MISSISSIPPI  
BOARD OF WATER COMMISSIONERS  
416 North State Street  
Jackson, Mississippi 39201

WATER WELL DRILLERS LOG

match 23 date well completed  
Fetive + Ellett Brown firm name  
WALTHALL county well located

LANDOWNER:

DAVID GRAVES  
TYLETOWN  
(mailing address)

description of formations encountered

from to

wh SANDY CL 0 15  
SAND + GRAVEL 15 78

WELL LOCATION:

sec 20 T 10 N R 10 E  
3 miles N of Hillsboro  
(distance) (direction) (nearest town)

WELL PURPOSE:


Home  
(home, irrigation, municipal, industrial)

WELL COMPLETION DATA:

- (1) diameter (inches) 4"
- (2) total depth (feet) 78'
- (3) static water level (feet) 44' below top of ground
- (4) casing PLASTIC 78' (material) (depth)  
4" (size) if telescope see back.
- (5) screen 5' 73' (length) (depth to top)  
4" PLASTIC (size) (material)
- (6) pump \_\_\_\_\_ (HP) \_\_\_\_\_ (yield gpm)  
(type power)
- (7) electric log \_\_\_\_\_ (yes or no)  
(organization running log)
- (8) how well bottom plugged BWV


DRILLERS REMARKS:

PUMP NO INSTALLED

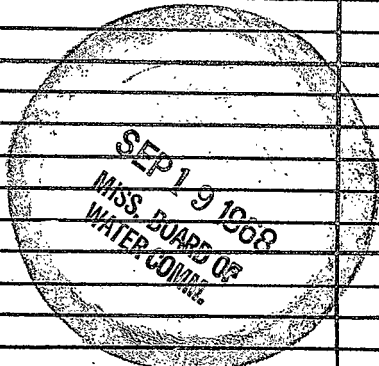

If well telescopes please sketch and show depths.

GROUND LEVEL

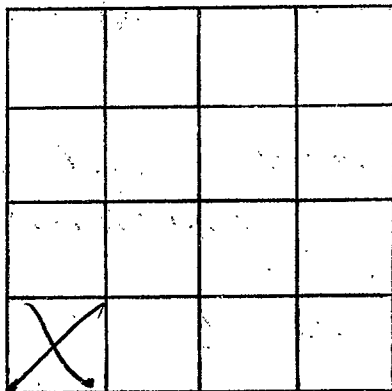

SECTION 20

Please indicate well location X.

ADDITIONAL INFORMATION

If more than one screen,  
show locations of each on sketch.