

MISSISSIPPI
 BOARD OF WATER COMMISSIONERS
 416 North State Street
 Jackson, Mississippi 39201

CODED

WATER WELL DRILLERS LOG

CODED

Walworth
H 35
1-20-69

1-20 1969 Fitzgerald Water Well Walworth
 date well completed firm name county well located

LANDOWNER: Donald Brook
Tylertown MS

description of formations encountered from to

(mailing address)

<u>Reel clay</u>	<u>0</u>	<u>20</u>
<u>Reel sand</u>	<u>20</u>	<u>80</u>
<u>Reel gravel</u>	<u>80</u>	<u>90</u>
<u>Reel sand</u>	<u>90</u>	<u>110</u>
<u>sand & gravel</u>	<u>110</u>	<u>122</u>

WELL LOCATION:
 sec. 25 T. 1 N. R. 9 E.
11 miles SW of Tylertown
 (distance) (direction) (nearest town)

WELL PURPOSE: home
 (home, irrigation, municipal, industrial)

WELL COMPLETION DATA:


- (1) diameter (inches) 4
- (2) total depth (feet) 122
- (3) static water level (feet) 85 below above top of ground.
- (4) casing Plastic, 116,
 (material) (depth)
4 if telescope see back.
 (size)
- (5) screen 6', 116'
 (length) (depth to top)
4, plastic
 (size) (material)
- (6) pump 1/2, 10
 (HP) (yield gpm)
elec
 (type power)
- (7) electric log no
 (yes or no)
Walworth
 (organization running log)
- (8) how well bottom plugged wood plug

DRILLERS REMARKS:

REC 7
 MISS. BD. OF WATER COMMISSIONERS

If well telescopes please sketch and show depths.

GROUND LEVEL

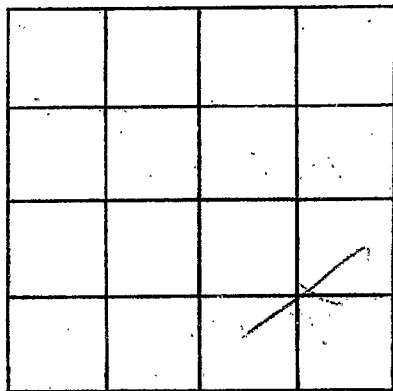

SECTION 25

Please indicate well location X.

ADDITIONAL INFORMATION

If more than one screen, show locations of each on sketch.