

Walthall
H 36
2-26-69

MISSISSIPPI
BOARD OF WATER COMMISSIONERS
416 North State Street
Jackson, Mississippi 39201

CODED

WATER WELL DRILLERS LOG

CODED

Feb 26 1969 *Fitzgerald Walthall*
date well completed firm name county well located

LANDOWNER:	description of formations encountered	from	to
<i>Sunny V. Dillon</i>			
<i>R.B. Tylburn, Min.</i> (mailing address)	<i>Red clay</i>	<i>0</i>	<i>20</i>
	<i>Red sand</i>	<i>20</i>	<i>40</i>
	<i>White clay</i>	<i>40</i>	<i>80</i>
	<i>Lower sand</i>	<i>80</i>	<i>90</i>
WELL LOCATION:			
sec. <i>23</i> T <i>1</i> N R <i>10</i> E S W			
<i>7</i> miles <i>SSW</i> of <i>Tylburn</i> (distance) (direction) (nearest town)			
WELL PURPOSE: <i>Home</i> (home, irrigation, municipal, industrial)			
WELL COMPLETION DATA:			
(1) diameter (inches) <i>4</i>			
(2) total depth (feet) <i>90'</i>			
(3) static water level (feet) <i>70</i> below top of ground.			
(4) casing <i>Plastic</i> <i>84</i> (material) (depth)			
<i>4</i> (size) if telescope see back.			
(5) screen <i>6</i> <i>84</i> (length) (depth to top)			
<i>4</i> (size) <i>Plastic</i> (material)			
(6) pump <i>3/4</i> <i>6</i> (HP) (yield gpm)			
<i>Other</i> (type power)			
(7) electric log <i>No</i> (yes or no)			
(organization running log)			
(8) how well bottom plugged <i>Good for</i>			
DRILLERS REMARKS:			


CODED

MAR 13 1969

REC. DIV. OF
STATE

If well telescopes please sketch and show depths.

GROUND LEVEL

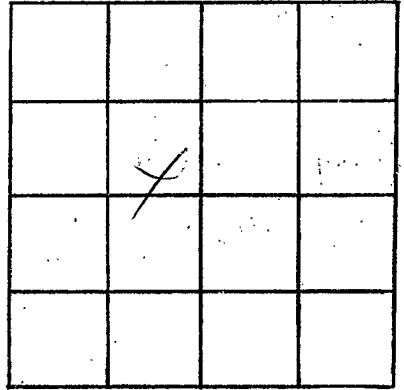

SECTION 23

Please indicate well location X.

ADDITIONAL INFORMATION

If more than one screen, show locations of each on sketch.