

COPIED

MISSISSIPPI
BOARD OF WATER COMMISSIONERS
416 North State Street
Jackson, Mississippi 39201

Walthall
H 37
4-7-69

WATER WELL DRILLERS LOG

4/7 1969 Essley Stafford Walthall
date well completed firm name county well located

LANDOWNER: Bill Board
Route 6
Tipton Miss.
(mailing address)

WELL LOCATION:
sec. 35 T. 1 N. R. 10 E
7 miles South of Tipton
(distance) (direction) (nearest town)

WELL PURPOSE: none
(home, irrigation, municipal, industrial)

WELL COMPLETION DATA:
(1) diameter (inches) 4"
(2) total depth (feet) 190'
(3) static water level (feet) 160' below above top of ground.
(4) casing (material) (depth) 180'
4" if telescope see back.
(size)
(5) screen (length) (depth to top) 10' 180'
4" (size) (material) Palle
(6) pump (HP) (yield gpm) 1/2 800
115 (type power)
(7) electric log (yes or no)
(organization running log)
(8) how well bottom plugged B.W.V.

description of formations encountered	from	to
clay	0	20
Sand	20	70
Chalk	70	150
Sandstone	150	190

COPIED


APR 14 1969

MISS. Bd. of
WATER CONTROL

DRILLERS REMARKS:
J.S. Marchand
Essley Stafford

If well telescopes please sketch and show depths.

GROUND LEVEL

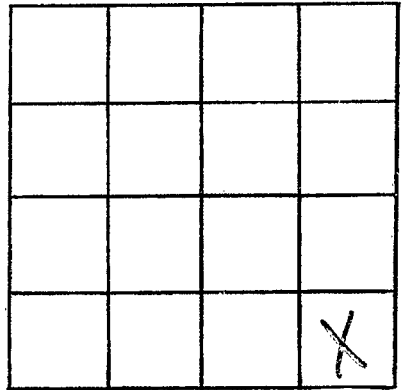

SECTION 35

Please indicate well location X.

ADDITIONAL INFORMATION

If more than one screen,
show locations of each on sketch.