

Walthall  
H 38  
4-23-69

MISSISSIPPI  
BOARD OF WATER COMMISSIONERS  
416 North State Street  
Jackson, Mississippi 39201

CODED

WATER WELL DRILLERS LOG

April 23 1969 Fernie Brown Walthall  
date well completed firm name county well located

LANDOWNER:  
Hoyt Boyd  
Tylertown Miss R. 6  
(mailing address)

description of formations encountered	from	to
<u>clay</u>	<u>0</u>	<u>15</u>
<u>sand &amp; gravel</u>	<u>15</u>	<u>105</u>
<u>gravel</u>	<u>105</u>	<u>126</u>

WELL LOCATION:  
sec 19 T 1 N R 10  
S WL  
3 1/2 miles SW of Lepie  
(distance) (direction) (nearest town)

WELL PURPOSE: Home  
(home, irrigation, municipal, industrial)

- WELL COMPLETION DATA:
- (1) diameter (inches) 4
  - (2) total depth (feet) 126
  - (3) static water level (feet) 81 below above top of ground.
  - (4) casing plastic, 126  
(material) (depth)  
         if telescope see back.  
(size)
  - (5) screen 6, 120  
(length) (depth to top)  
         (size)          (material)
  - (6) pump 1 7  
(HP) (yield gpm)  
elec  
(type power)
  - (7) electric log NO  
(yes or no)  
      
(organization running log)
  - (8) how well bottom plugged WV

CODED

CODED


APR 28 1969

DRILLERS REMARKS: Replace old well

MISS. BD. OF WATER COMMISSIONERS

If well telescopes please sketch and show depths.

GROUND LEVEL

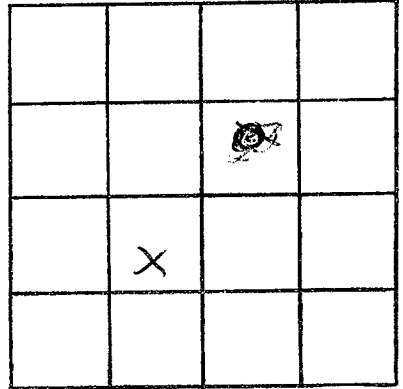

SECTION 19

Please indicate well location X.

ADDITIONAL INFORMATION

If more than one screen,  
show locations of each on sketch.