

CODED

Walthall
H 41
7-69

MISSISSIPPI
BOARD OF WATER COMMISSIONERS
416 North State Street
Jackson, Mississippi 39201

WATER WELL DRILLERS LOG

July 5 1969 R. Woodward Drilling WALTHALL
date well completed firm name county well located

LANDOWNER: <u>M. Shelby Gunn</u> Rt.	description of formations encountered	from	to
<u>Tylertown, Miss.</u> (mailing address)	<u>white sand and gravel</u>		<u>23</u>
WELL LOCATION: sec. <u>18</u> T. <u>1</u> (N) R. <u>10</u> (E) <u>6</u> miles <u>W</u> of <u>Lexie</u> (distance) (direction) (nearest town)	<u>white clay</u>	<u>23</u>	<u>51</u>
WELL PURPOSE: <u>INDUSTRIAL</u> (home, irrigation, municipal, industrial)	<u>sand</u>	<u>51</u>	<u>75</u>
WELL COMPLETION DATA:			
(1) diameter (inches) <u>4"</u>			
(2) total depth (feet) <u>75'</u>			
(3) static water level (feet) <u>8</u> <u>below</u> top of ground. <u>above</u>			
(4) casing <u>PLASTIC</u> <u>67'</u> (material) (depth)			
<u>4"</u> If telescope see back. (size)			
(5) screen <u>8'</u> <u>67'</u> (length) (depth to top)			
<u>4"</u> <u>PLASTIC</u> (size) (material)			
(6) pump <u>3/4</u> <u>8</u> (HP) (yield gpm)			
<u>Electric</u> (type power)			
(7) electric log <u>NO</u> (yes or no)			
(organization running log)			
(8) how well bottom plugged <u>FLOAT</u> <u>TYPE BACKWASH VALVE</u>			


AUG 6 1969

MISS. BUREAU OF
WATER COMMISSIONERS

DRILLERS REMARKS:

If well telescopes please sketch and show depths.

GROUND LEVEL

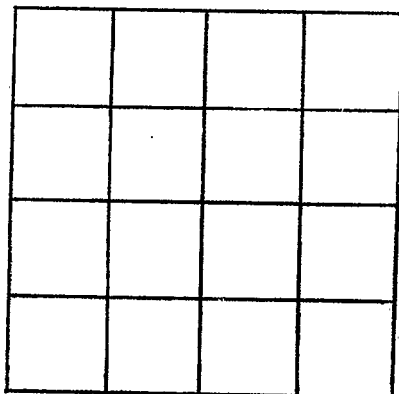

SECTION 18

Please indicate well location X.

ADDITIONAL INFORMATION

A series of horizontal lines for recording additional information.

If more than one screen, show locations of each on sketch.