

WALTHALL

MISSISSIPPI
BOARD OF WATER COMMISSIONERS
416 North State Street
Jackson, Mississippi 39201

CODED CODED

Walthall

WATER WELL DRILLERS LOG

| |
|------------------|
| _____ |
| H42 |
| 9-68 |
| |

Sept. 13 1968 J. T. Conington
 date well completed firm name county well located

LANDOWNER: C. P. Williams
 Progress, Miss (mailing address)

| description of formations encountered | from | to |
|---------------------------------------|------|-----|
| 2 1/2 ft sand | 0 | 40 |
| sand & rocks | 40 | 108 |

WELL LOCATION:
 sec. 9 T. 1 N. R. 9 E
 S. W.
 5 miles East of Progress
 (distance) (direction) (nearest town)

WELL PURPOSE: Home
 (home, irrigation, municipal, industrial)

WELL COMPLETION DATA:

(1) diameter (inches) 4"

(2) total depth (feet) 108'

(3) static water level (feet) 85' below above top of ground.


(4) casing Plastic, 102' (material) (depth)
 (size) if telescope see back.

(5) screen 6' 102' (length) (depth to top)
 4" Plastic (size) (material)

(6) pump 1/2 5 (HP) (yield gpm)
 A.C. (type power)

(7) electric log _____ (yes or no)
 _____ (organization running log)


(8) how well bottom plugged Wood

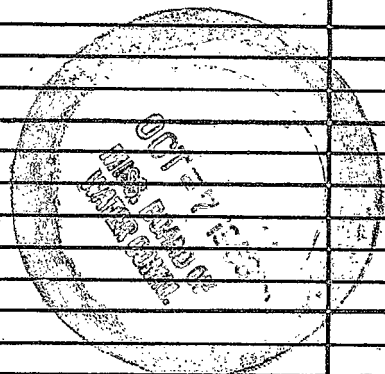

DRILLERS REMARKS:

If well telescopes please sketch and show depths.

GROUND LEVEL

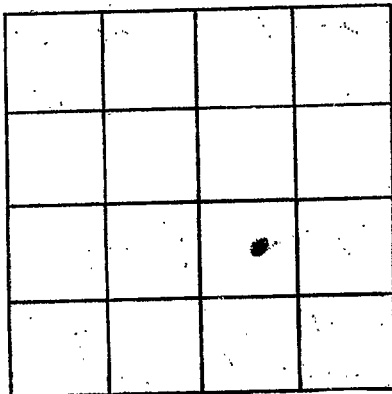

SECTION 8

Please indicate well location X.

ADDITIONAL INFORMATION

If more than one screen,
show locations of each on sketch.