

**MISSISSIPPI
BOARD OF WATER COMMISSIONERS**
416 North State Street
Jackson, Mississippi 39201

CODED

CODED

Walthall
H 43
9-15-69

WATER WELL DRILLERS LOG

9-15 1969 Fitzgerald Well Serv. Walthall
date well completed firm name county well located


LANDOWNER:	description of formations encountered	from	to
<u>Harold Celford</u>			
<u>RR. Tylertown, Miss.</u> (mailing address)	<u>Red clay</u>	<u>0</u>	<u>20</u>
	<u>Red sand</u>	<u>20</u>	<u>80</u>
	<u>Red gravel</u>	<u>80</u>	<u>100</u>
	<u>loose sand & gravel</u>	<u>100</u>	<u>130</u>
WELL LOCATION:			
sec. <u>25</u> T <u>1</u> N R <u>9</u> E <u>5</u> <u>W</u>			
<u>8</u> miles <u>SW</u> of <u>Tylertown</u> (distance) (direction) (nearest town)			
WELL PURPOSE: <u>Home</u> (home, irrigation, municipal, industrial)			
WELL COMPLETION DATA:			
(1) diameter (inches) <u>4</u>			
(2) total depth (feet) <u>130</u>			
(3) static water level (feet) <u>80</u> below top of ground.			
(4) casing <u>4</u> <u>123</u> (material) (depth)			
<u>4</u> (size) if telescope see back.			
(5) screen <u>8</u> <u>122</u> (length) (depth to top)			
<u>4</u> <u>Plastic</u> (size) (material)			
(6) pump <u>1/2</u> <u>10</u> (HP) (yield gpm)			
<u>Electric</u> (type power)			
(7) electric log <u>no</u> (yes or no)			
(organization running log)			
(8) how well bottom plugged <u>wood plug</u>			
DRILLERS REMARKS:			

OCT 20 1969

MISS. STATE BOARD OF WATER COMMISSIONERS

If well telescopes please sketch and show depths.

GROUND LEVEL

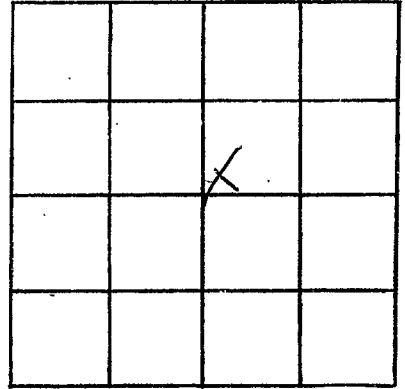

SECTION 25

Please indicate well location X.

ADDITIONAL INFORMATION

If more than one screen,
show locations of each on sketch.