

WALTHALL

HA4

12-3-69

MISSISSIPPI
 BOARD OF WATER COMMISSIONERS
 416 North State Street
 Jackson, Mississippi 39201

CODED CODE-L

WATER WELL DRILLERS LOG

12-3 1969 date well completed

Fitzgerald Well Serv firm name

Walthall county well located

LANDOWNER:

Dale Rayborn

R.R. Tylburn, Miss. (mailing address)

WELL LOCATION:

sec. 6 T. 1 N R. 10 E
 S W
 10 miles SW of Tylburn
 (distance) (direction) (nearest town)

WELL PURPOSE: None (home, irrigation, municipal, industrial)

WELL COMPLETION DATA:

- (1) diameter (inches) 4
- (2) total depth (feet) 160
- (3) static water level (feet) 80 below top of ground.
- (4) casing (material) Metal (depth) 154
 4 (size) if telescope see back.
- (5) screen (length) 6 (depth to top) 154
 4 (size) plastic (material)
- (6) pump (HP) 7 (yield gpm) 7
 7 (type power)
- (7) electric log no (yes or no)
- (organization running log)
- (8) how well bottom plugged correct

description of formations encountered

from to

Red Clay	0	15
fine sand	15	80
white chalk	80	130
loose sand	130	160


DRILLERS REMARKS:

DEC 22 1969

MISS. BD. OF WATER COMMISSIONERS

If well telescopes please sketch and show depths.

GROUND LEVEL

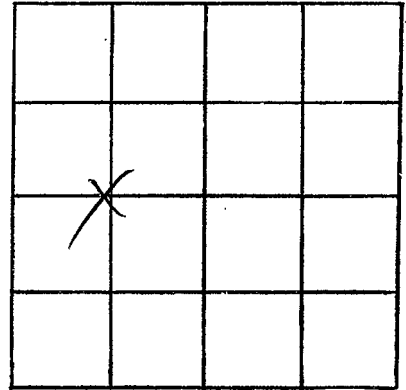

SECTION 6

Please indicate well location X.

ADDITIONAL INFORMATION

If more than one screen,
show locations of each on sketch.