

WALTHALL  
H45  
12-4-69

MISSISSIPPI  
BOARD OF WATER COMMISSIONERS  
416 North State Street  
Jackson, Mississippi 39201

CODED  
CODED

WATER WELL DRILLERS LOG

12-4 1969 Fitzgerald Wellbore Walthall  
date well completed firm name county well located

LANDOWNER:  
Russell Dillon  
R.R. Tylertown, Miss.  
(mailing address)

description of formations encountered	from	to
<u>Red clay</u>	<u>0</u>	<u>10</u>
<u>Fine sand</u>	<u>10</u>	<u>20</u>
<u>White cherty</u>	<u>20</u>	<u>95</u>
<u>Coarse sand</u>	<u>95</u>	<u>104</u>

WELL LOCATION:  
sec 15 T 1 N R 10 E  
S W  
6 miles S of Tylertown  
(distance) (direction) (nearest town)

WELL PURPOSE: Home  
(home, irrigation, municipal, industrial)


- WELL COMPLETION DATA:
- (1) diameter (inches) 4
  - (2) total depth (feet) 104
  - (3) static water level (feet) 18 below top of ground.
  - (4) casing Galvasteel, 94 (material) (depth)  
4 if telescope see back. (size)
  - (5) screen 8, 94 (length) (depth to top)  
4, Galvasteel (size) (material)
  - (6) pump ?, ? (HP) (yield gpm)  
? (type power)
  - (7) electric log no (yes or no)  
(organization running log)
  - (8) how well bottom plugged Wood plug

DRILLERS REMARKS:

22 1969

If well telescopes please sketch and show depths.

GROUND LEVEL

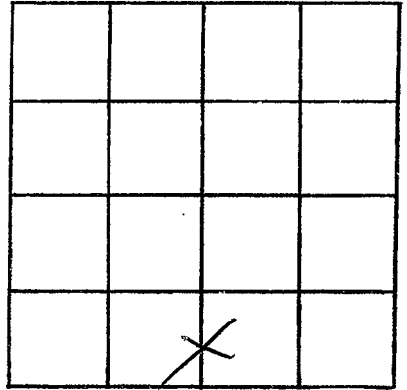

SECTION 15

Please indicate well location X.

ADDITIONAL INFORMATION

If more than one screen,  
show locations of each on sketch.