

WALTHALL

H 46

12-5-69

MISSISSIPPI BOARD OF WATER COMMISSIONERS
416 North State Street
Jackson, Mississippi 39201

CODED

CODED

WATER WELL DRILLERS LOG

12-5 1969 *Fitzgerald well Ltd* *Walthall*
date well completed firm name county well located

LANDOWNER:

Wilma Dellon

P.R. Gledhill, Miss.
(mailing address)

description of formations encountered

from to

Red clay 0 20
Red Sand 20 100
Red gravel 100 140
Coarse Sand 140 155

WELL LOCATION:

sec. *12* T *1* N S R. *10* E W
7 miles *SE* of *Fylston*
(distance) (direction) (nearest town)

WELL PURPOSE: *Home*
(home, irrigation, municipal, industrial)

WELL COMPLETION DATA:


- (1) diameter (inches) *4*
- (2) total depth (feet) *155*
- (3) static water level (feet) *90* below top of ground.
- (4) casing *plastic* *147*,
(material) (depth)
(size) if telescope see back.
- (5) screen *8* *147*,
(length) (depth to top)
4 *plastic*
(size) (material)
- (6) pump *?* *?*
(HP) (yield gpm)
(type power)
- (7) electric log *no*
(yes or no)
(organization running log)
- (8) how well bottom plugged *wood peg*

DRILLERS REMARKS:

DEC 22 1969

If well telescopes please sketch and show depths.

GROUND LEVEL

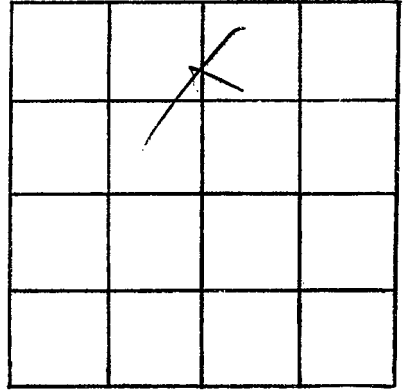

SECTION 12

Please indicate well location X.

ADDITIONAL INFORMATION

If more than one screen,
show locations of each on sketch.