

CODED  
CODED

MISSISSIPPI  
BOARD OF WATER COMMISSIONERS  
416 North State Street  
Jackson, Mississippi 39201

WALTHALL  
H 47  
12-11-69

WATER WELL DRILLERS LOG

Dec 11 1969 P. Essley Stafford Water Well Service  
date well completed firm name county well located  
Walthall

LANDOWNER: Printice Hughes  
  
(mailing address)

description of formations encountered	from	to
Chalk	0	40
Sand & Gravel	40	105

WELL LOCATION:  
sec. 35 T 1 N R 10 E  
10 miles South of Tylertown  
(distance) (direction) (nearest town)

WELL PURPOSE:  
(home, irrigation, municipal, industrial)

WELL COMPLETION DATA:

(1) diameter (inches) 4 in

(2) total depth (feet) 105

(3) static water level (feet) 65 below above top of ground.

(4) casing Plastic 105  
(material) (depth)

4 in  
(size) If telescope see back.

(5) screen 20 ft 95 ft  
(length) (depth to top)

4 in Plastic  
(size) (material)

(6) pump 1 jet 1500 hr  
(HP) (yield gpm)

Elec  
(type power)

(7) electric log no  
(yes or no)

(organization running log)

(8) how well bottom plugged B.W.V.


DEC 29 1969

MISS. DEPT. OF  
WATER RESOURCES

DRILLERS REMARKS:  
Charles Stafford

If well telescopes please sketch and show depths.

GROUND LEVEL

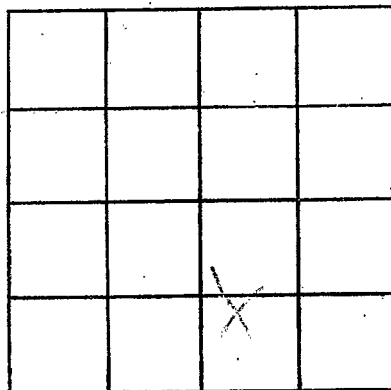

SECTION \_\_\_\_\_

Please indicate well location X.

ADDITIONAL INFORMATION

If more than one screen, show locations of each on sketch.