

Walthall
H48
12-1-69

MISSISSIPPI
BOARD OF WATER COMMISSIONERS
416 North State Street
Jackson, Mississippi 39201

CODED

WATER WELL DRILLERS LOG

Dec 1 1969 date well completed
S.A. Kern Well Pump Co. firm name
Walthall county well located

LANDOWNER: Hugh M. Smith Sr.
Rt 6, Tylentown, Miss (mailing address)

| description of formations encountered | from | to |
|---------------------------------------|------|----|
| Sand | 0 | 6 |
| white & blue chalk | 6 | 17 |
| Brown sand | 17 | 48 |
| Red gravel | 48 | 54 |

WELL LOCATION:
sec. 2 T 1 N R 10 E
4 miles SW Tylentown (distance) (direction) (nearest town)

WELL PURPOSE: Farm (home, irrigation, municipal, industrial)

- WELL COMPLETION DATA:
- (1) diameter (inches) 4"
 - (2) total depth (feet) 54
 - (3) static water level (feet) 3 below top of ground.
 - (4) casing Plastic Bottom (material) (depth)
 - (5) screen 6' 48" (length) (depth to top)
4" Plastic (size) (material)
 - (6) pump Old Pump (HP) (yield gpm)
Electric (type power)
 - (7) electric log NO- (yes or no)
 - (organization running log)

(8) how well bottom plugged
wooden plug


DRILLERS REMARKS:
Old 2" flow well bad

JAN 5 1970

MISS. DE. OF WATER

If well telescopes please sketch and show depths.

GROUND LEVEL

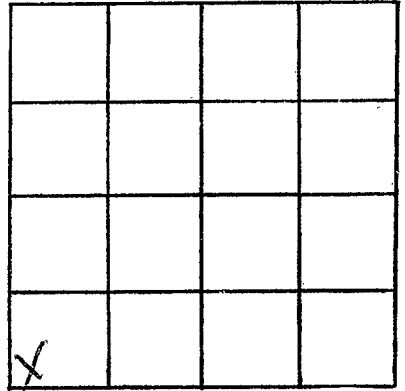

SECTION 2

Please indicate well location X.

ADDITIONAL INFORMATION

If more than one screen,
show locations of each on sketch.