

Walthall
H 50
10-70

MISSISSIPPI
BOARD OF WATER COMMISSIONERS
416 North State Street
Jackson, Mississippi 39201

CODED

WATER WELL DRILLERS LOG

Oct 19 70 LEVINER DRILLING SERVICE Walthall
date well completed firm name county well located

LANDOWNER: Lexie
Water Ass'n.
Tyke town
(mailing address)

description of formations encountered	from	to
	<u>Top Soil</u>	<u>0</u>
<u>Clay</u>	<u>2</u>	<u>288</u>
<u>SAND</u>	<u>288</u>	<u>388</u>

WELL LOCATION:
sec. 12 T. 1N N R. 10E E
S W
5 miles S of Tyke town
(distance) (direction) (nearest town)

WELL PURPOSE: Municipal
(home, irrigation, municipal, industrial)

- WELL COMPLETION DATA:
- (1) diameter (inches) 12"
 - (2) total depth (feet) 380'
 - (3) static water level (feet) 90' below above top of ground.
 - (4) casing Steel, 330,
" (material) (depth),
12' if telescope see back.
(size)
 - (5) screen 140', 340'
(length) (depth to top)
8", 5.5.
(size) (material)
 - (6) pump 15 250
(HP) (yield gpm)
Etc
(type power)
 - (7) electric log Yes
(yes or no)
USFS
(organization running log)
 - (8) how well bottom plugged Back
WASH WATER

CODED

SEP 24 1970


MISS. BD. OF
WATER COMMISSIONERS

DRILLERS REMARKS:

7

If well telescopes please sketch and show depths.

GROUND LEVEL

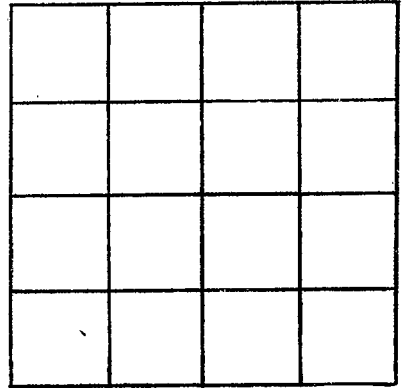

SECTION _____

Please indicate well location X.

ADDITIONAL INFORMATION

A series of horizontal lines providing space for additional information.

If more than one screen, show locations of each on sketch.