

WALTHALL
H 53
2-3-71

MISSISSIPPI
BOARD OF WATER COMMISSIONERS
416 North State Street
Jackson, Mississippi 39201

CODED

WATER WELL DRILLERS LOG

2-3 19 71 Fitzgerald well Walthall
date well completed firm name county well located

LANDOWNER:
R. A. Campbell
R.R. Tylistone
(mailing address)
WELL LOCATION:
sec. 2 T. 10 S. R. 10 E
1 1/4 miles SE of Lebanon
(distance) (direction) (nearest town)

description of formations encountered	from	to
<u>Red Clay</u>	<u>0</u>	<u>10</u>
<u>White Clay</u>	<u>10</u>	<u>60</u>
<u>Blue Clay</u>	<u>60</u>	<u>74</u>
<u>Limestone</u>	<u>74</u>	<u>82</u>

WELL PURPOSE: Home
(home, irrigation, municipal, industrial)

- WELL COMPLETION DATA:
- (1) diameter (inches) 4
 - (2) total depth (feet) 82
 - (3) static water level (feet) 1 below above top of ground.
 - (4) casing Plast 76
(material) (depth)
4 if telescope see back.
(size)
 - (5) screen 6 76
(length) (depth to top)
4 Plast
(size) (material)
 - (6) pump 1/2 10
(HP) (yield gpm)
96
(type power)
 - (7) electric log no
(yes or no)
(organization running log)
 - (8) how well bottom plugged cleanly

CODED


FEB 17 1971

DRILLERS REMARKS:

MISS. Bd. of WATER COMMISSIONERS

If well telescopes please sketch and show depths.

GROUND LEVEL

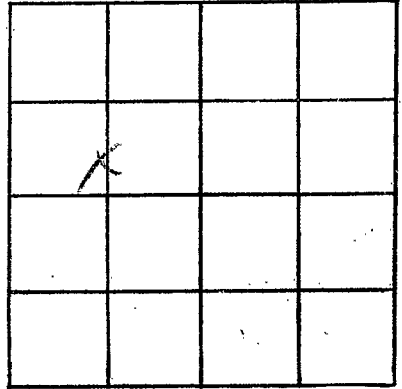

SECTION 2

Please indicate well location X.

ADDITIONAL INFORMATION

If more than one screen, show locations of each on sketch.