

CODED

MISSISSIPPI
BOARD OF WATER COMMISSIONERS
416 North State Street
Jackson, Mississippi 39201

FEB 19 1971

MISS. BD. OF
WATER COMM.

WATER WELL DRILLERS LOG

WALTHALL
H59
1-14-71

Jan 14 1971 date well completed
Chester Keener Walthall firm name
county well located

LANDOWNER: Summit Davis
PTD - Tylertown
(mailing address)

WELL LOCATION:
sec. 24 T. 1 N. R. 10 E.
5 miles S of Tylertown
(distance) (direction) (nearest town)

WELL PURPOSE: Home
(home, irrigation, municipal, industrial)

- WELL COMPLETION DATA:
- (1) diameter (inches) 4"
 - (2) total depth (feet) 265
 - (3) static water level (feet) 67 below top of ground.
 - (4) casing Plast (material) bottom (depth)
 - (5) screen 6' (length) 259' (depth to top)
4 1/2" (size) Plast (material)
 - (6) pump sedlet pump by owner (HP) (yield gpm)
 - (7) electric log no (yes or no)
- (organization running log)


(8) how well bottom plugged wooden plug
DRILLERS REMARKS: old well hole

description of formations encountered	from	to
clay	0	8
chalk	8	20
chalky sand	20	40
sand	40	70
chalky sand	70	100
chalk	100	120
chalky sand	120	200
sand over gravel	200	265

CODED

If well telescopes please sketch and show depths.

GROUND LEVEL

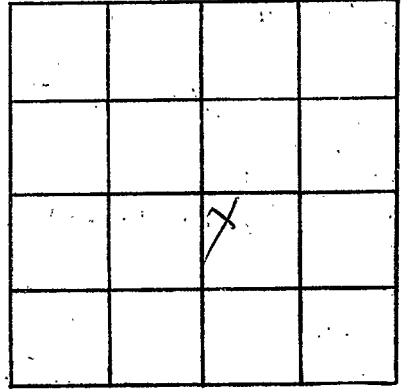

SECTION 24

Please indicate well location X.

ADDITIONAL INFORMATION

If more than one screen, show locations of each on sketch.