

WALTHALL
H 57
2-8-72

MISSISSIPPI
BOARD OF WATER COMMISSIONERS
416 North State Street
Jackson, Mississippi 39201

CODED

WATER WELL DRILLERS LOG

Feb 4 1972 Chester Kenna Walthall
date well completed firm name county well located

LANDOWNER A.B. Ireland

description of formations encountered

from to

RF 6 -
Tylertown, Miss.
(mailing address)

<u>Red clay</u>	<u>0</u>	<u>14</u>
<u>Red Sand Gravel</u>	<u>14</u>	<u>48</u>
<u>Brown Gravel</u>	<u>48</u>	<u>70</u>

WELL LOCATION:

sec. 15 T. 1 N. R. 10 E
4 miles S.S.W of Tylertown
(distance) (direction) (nearest town)

WELL PURPOSE: Home
(home, irrigation, municipal, industrial)

WELL COMPLETION DATA:

- (1) diameter (inches) 4"
- (2) total depth (feet) 70
- (3) static water level (feet) 37 below top of ground. above
- (4) casing Plastic Bottom
(material) (depth)
- (size) If telescope see back.
- (5) screen 6' 64'
(length) (depth to top)
4" Plast.
(size) (material)
- (6) pump 1/2 SS Jet - 4"
(HP) (yield gpm)
Elect.
(type power)
- (7) electric log no
(yes or no)

(organization running log)

(8) how well bottom plugged was sampled

DRILLERS REMARKS:
old system bad


CODED

MAY 20 1972

MISS. Bd. OF
WATER COMMISSIONERS

If well telescopes please sketch and show depths.

GROUND LEVEL

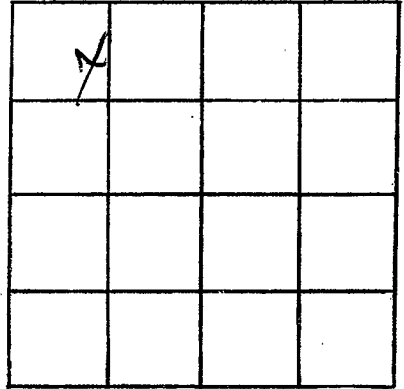

SECTION 15

Please indicate well location X.

ADDITIONAL INFORMATION

If more than one screen, show locations of each on sketch.