

WALTHALL
H 58
6-19-72

MISSISSIPPI
BOARD OF WATER COMMISSIONERS
416 North State Street
Jackson, Mississippi 39201

WATER WELL DRILLERS LOG

CODED

6-19
date well completed

1972 *Fitzgerald*
firm name

Walthall
county well located


LANDOWNER:	description of formations encountered	from	to	
<i>Keith Dillon Jr.</i>	<i>Red clay ground</i>	0	20	
<i>Reh. F. Johnston</i> (mailing address)	<i>white clay</i>	20	100	
	<i>Green sand ground</i>	100	110	
<p>WELL LOCATION:</p> <p>sec. <u>16</u> T. <u>1</u> N. R. <u>10</u> E</p> <p><u>2</u> miles <u>S</u> of <u>Levie</u> (distance) (direction) (nearest town)</p>				
<p>WELL PURPOSE: (home, irrigation, municipal, industrial)</p>				
<p>WELL COMPLETION DATA:</p>				
(1) diameter (inches) <u>4</u>	CODED			
(2) total depth (feet) <u>110</u>				
(3) static water level (feet) <u>20</u> below top of ground.				
(4) casing <u>plastic</u> <u>102</u> (material) (depth)				
<u>4</u> if telescope see back. (size)				
(5) screen <u>8</u> <u>102</u> (length) (depth to top)				
<u>4</u> <u>plastic</u> (size) (material)				
(6) pump <u>1/2</u> <u>12</u> (HP) (yield gpm)				
<u>elec</u> (type power)				
(7) electric log <u>no</u> (yes or no)				
(organization running log)				
(8) how well bottom plugged <u>wood peg</u>				
DRILLERS REMARKS:				

JUNE 21 1972

MISS. BD. OF
WATER COMMISSIONERS

If well telescopes please sketch and show depths.

GROUND LEVEL

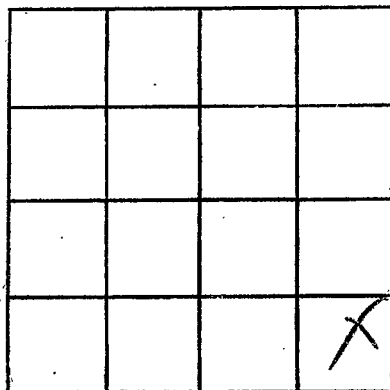

SECTION 16

Please indicate well location X.

ADDITIONAL INFORMATION

If more than one screen,
show locations of each on sketch.