

WALTHALL

MISSISSIPPI BOARD OF WATER COMMISSIONERS
416 North State Street
Jackson, Mississippi 39201

WATER WELL DRILLERS LOG

Walthall

FILE
H 60
9-30-72

9-30 1972 *Fitzgerald* **CODED** *Walthall*
 date well completed firm name county well located

LANDOWNER:
Olin Van Dorn
R.R. Fitzgerald
 (mailing address)

description of formations encountered	from	to
<i>Brown Clay</i>	0	15
<i>coarse sand gravel</i>	15	40
<i>Fine Sand</i>	40	87
<i>coarse sand gravel</i>	87	98

WELL LOCATION:
 sec. 29 T. 1 N R. 1 E
7 miles SSW of Lexie
 (distance) (direction) (nearest town)

WELL PURPOSE: Hog Farm
 (home, irrigation, municipal, industrial)

- WELL COMPLETION DATA:
- (1) diameter (inches) 4
 - (2) total depth (feet) 98
 - (3) static water level (feet) 15 below above top of ground.
 - (4) casing plastic 90
 (material) (depth)
4 if telescope see back.
 (size)
 - (5) screen 8 90
 (length) (depth to top)
4 plastic
 (size) (material)
 - (6) pump 1 1.5
 (HP) (yield gpm)
elm
 (type power)
 - (7) electric log no
 (yes or no)
 (organization running log)
 - (8) how well bottom plugged wood plug

CODED


OCT 17 1972

DRILLERS REMARKS:

ALL OF
WELL LOGS

If well telescopes please sketch and show depths.

GROUND LEVEL

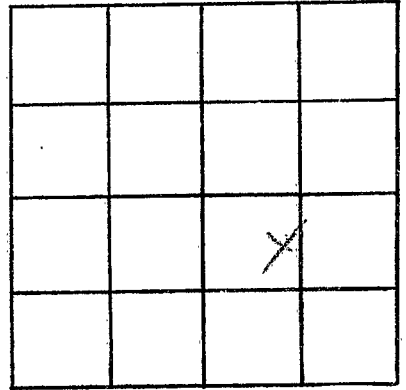

SECTION 29

Please indicate well location X.

ADDITIONAL INFORMATION

If more than one screen,
show locations of each on sketch.