

**WALTHALL**  
**H 63**  
**11-14-73**

MISSISSIPPI  
 BOARD OF WATER COMMISSIONERS  
 416 North State Street  
 Jackson, Mississippi 39201

CODED

WATER WELL DRILLERS LOG

Nov. 14 1973 A. Woodward Drilling Walthall  
 date well completed firm name county well located

LANDOWNER	description of formations encountered	from	to
<u>Percy Brooks</u> <u>Rt.</u>	<u>Red Clay gravel</u>		<u>15</u>
<u>Tylertown, Miss.</u> (mailing address)	<u>sand of gravel</u>	<u>15</u>	<u>32</u>
WELL LOCATION: sec. <u>17</u> T. <u>1</u> N. R. <u>10</u> E <u>6</u> miles <u>SW</u> of <u>Lexie</u> (distance) (direction) (nearest town)	<u>clay</u>	<u>32</u>	<u>61</u>
	<u>good sand</u>	<u>61</u>	<u>70</u>
WELL PURPOSE: <u>Home</u> (home, irrigation, municipal, industrial)			
WELL COMPLETION DATA:			
(1) diameter (inches) <u>2</u>			
(2) total depth (feet) <u>70'</u>			
(3) static water level (feet) <u>8</u> below top of ground. above			
(4) casing <u>2" PVC</u> , <u>65'</u> (material) (depth) (size) if telescope see back.			
(5) screen <u>5'</u> , <u>65'</u> (length) (depth to top) <u>2" x 0.15" PVC SCH. 40</u> (size) (material)			
(6) pump <u>1/2</u> , <u>5</u> (HP) (yield gpm) <u>115 V AC</u> (type power)			
(7) electric log <u>No.</u> (yes or no) (organization running log)			
(8) how well bottom plugged <u>Floated Type</u> <u>B.W.V.</u>			

CODED


NOV 28 1973

DRILLERS REMARKS:

MISS. HD. OF  
 WATER COMMISSIONERS

If well telescopes please sketch and show depths.

GROUND LEVEL

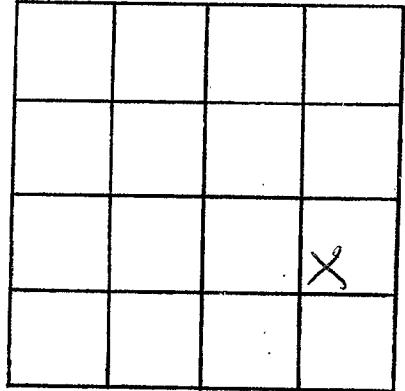

SECTION 17

Please indicate well location X.

ADDITIONAL INFORMATION

A series of horizontal lines for writing additional information, starting below the 'ADDITIONAL INFORMATION' header and extending to the bottom of the page.

If more than one screen, show locations of each on sketch.