

**KIALTHALL**  
**H64**  
**11-24-73**

MISSISSIPPI  
 BOARD OF WATER COMMISSIONERS  
 416 North State Street  
 Jackson, Mississippi 39201

**CODED**

**WATER WELL DRILLERS LOG**

Nov. 24 1973 R. Woodward Drilling Walthall  
 date well completed firm name county well located

LANDOWNER: <u>Bobby M. Ginn</u>	description of formations encountered	from	to
<u>Rt.</u>			
<u>Tylertown, Miss.</u> (mailing address)	<u>red clay</u>		<u>8</u>
<b>WELL LOCATION:</b> <u>(Sec. 8) T. 1 N. R. 10 E.</u> <u>6</u> miles <u>SW</u> of <u>Lexie</u> (distance) (direction) (nearest town)	<u>Red Clay &amp; Gravel</u>	<u>3</u>	<u>8</u>
<b>WELL PURPOSE:</b> <u>Home</u> (home, irrigation, municipal, industrial)	<u>White sand gravel</u>	<u>8</u>	<u>40</u>
<b>WELL COMPLETION DATA:</b>	<u>gray clay</u>	<u>40</u>	<u>92</u>
(1) diameter (inches) <u>2</u>	<u>fine sand</u>	<u>92</u>	<u>105</u>
(2) total depth (feet) <u>170'</u>	<u>Blue shale</u>	<u>105</u>	<u>143</u>
(3) static water level (feet) <u>16</u> <sup>below</sup> above top of ground.	<u>Blue sand</u>	<u>143</u>	<u>170</u>
(4) casing <u>PVC</u> <u>125'</u> (material) (depth)			
(size) if telescope see back.			
(5) screen <u>None</u> (length) (depth to top)			
(size) (material)			
(6) pump _____ (HP) (yield gpm)			
(type power)			
(7) electric log <u>No</u> (yes or no)			
(organization running log)			
(8) how well bottom plugged <u>NOT OPEN</u>			


NOV 28 1973

DRILLERS REMARKS:

MISS. BD. OF  
 WATER

If well telescopes please sketch and show depths.

GROUND LEVEL

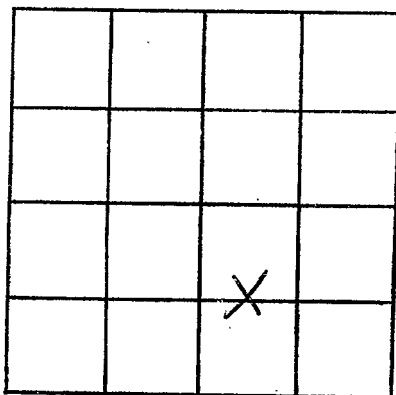

SECTION 8

Please indicate well location X.

ADDITIONAL INFORMATION

Lined area for additional information.

If more than one screen, show locations of each on sketch.