

WALTHALL
H 65
12-4-73

MISSISSIPPI **CODED**
 BOARD OF WATER COMMISSIONERS
 416 North State Street
 Jackson, Mississippi 39201

WATER WELL DRILLERS LOG

Dec. 04 1973 R. Woodward Drilling Walthall
 date well completed firm name county well located

LANDOWNER:	description of formations encountered	from	to
<u>J. O. Barnes</u>	<u>Sandy Red clay</u>		<u>35</u>
<u>Tylertown, Miss</u> (mailing address)	<u>Sand w/ small gravel</u>	<u>35</u>	<u>80</u>
WELL LOCATION:	<u>pink clay</u>	<u>80</u>	<u>84</u>
sec. <u>13</u> T. <u>1</u> N. R. <u>9</u> E	<u>Sand w/ large gravel</u>	<u>84</u>	<u>110</u>
<u>12</u> miles <u>WSW</u> of <u>Lexie</u> (distance) (direction) (nearest town)	<u>Clay</u>	<u>110</u>	
WELL PURPOSE: (home, irrigation, municipal, industrial)			
WELL COMPLETION DATA:			
(1) diameter (inches) <u>4"</u>			
(2) total depth (feet) <u>110'</u>			
(3) static water level (feet) <u>85</u> below top of ground.			
(4) casing <u>4" PVC</u> <u>100'</u> (material) (depth)			
<u>4"</u> if telescope see back. (size)			
(5) screen <u>10'</u> <u>100'</u> (length) (depth to top)			
<u>4" x .015"</u> <u>PVC SCH. 40</u> (size) (material)			
(6) pump <u>1</u> <u>8</u> (HP) (yield gpm)			
<u>115 V AC</u> (type power)			
(7) electric log <u>NO</u> (yes or no)			
(organization running log)			
(8) how well bottom plugged <u>flat top</u> <u>BND</u>			

CODED


DEC 29 1973

DRILLERS REMARKS:

MISS. REG. OF
 WATER

If well telescopes please sketch and show depths.

GROUND LEVEL

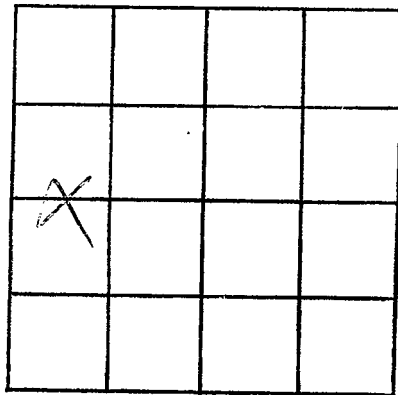

SECTION 13

Please indicate well location X.

ADDITIONAL INFORMATION

Lined area for additional information.

If more than one screen, show locations of each on sketch.