

WALTHALL

H 66

2-18-74

MISSISSIPPI BOARD OF WATER COMMISSIONERS 416 North State Street Jackson, Mississippi 39201

CODED

WATER WELL DRILLERS LOG

2-18-74 date well completed

Staffed Water Well Dr. Walthall firm name

county well located

LANDOWNER: Kinch Miley

Rt-2 Box 78

Tylertown Miss (mailing address)

description of formations encountered

from

to

Top soil

0 22

Chalk

22 80

sand

80 90

Sand & gravel

90 116

WELL LOCATION:

sec. 12 T-2 N R-9 E 10 miles S west of Tylertown (distance) (direction) (nearest town)

WELL PURPOSE: (home, irrigation, municipal, industrial)

WELL COMPLETION DATA:

- (1) diameter (inches) 4
(2) total depth (feet) 116
(3) static water level (feet) 8 below top of ground
(4) casing (material) 4 (depth) 96
(5) screen (length) 16 (depth to top) 96
(6) pump (HP) 1/2 (yield gpm) 20
(7) electric log (yes or no)
(8) how well bottom plugged B.W.V

CODED


DISCOVERED... FEB 22 1974... MISSISSIPPI WATER BOARD

DRILLERS REMARKS:

Cleve Duncan

If well telescopes please sketch and show depths.

GROUND LEVEL

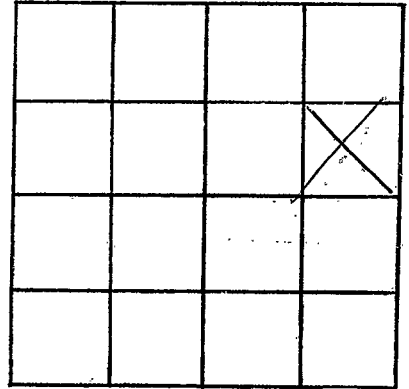

SECTION _____

Please indicate well location X.

ADDITIONAL INFORMATION

If more than one screen,
show locations of each on sketch.