

Walthall  
H 69  
1-31-75

MISSISSIPPI  
BOARD OF WATER COMMISSIONERS  
416 North State Street  
Jackson, Mississippi 39201

CODED

WATER WELL DRILLERS LOG

11/31/75 19 Stafford Well Jr Walthall  
date well completed firm name county well located

LANDOWNER: Ruthie Brock

description of formations encountered	from	to
top soil	0	10
clay gravel	10	50
chalk	50	200
sand	20	120

Orytha Miss.  
(mailing address)

WELL LOCATION:  
sec. 1 T. 10 N. R. 10 E. <sup>134</sup>  
2 miles S of Subertown  
(distance) (direction) (nearest town)

WELL PURPOSE:  
(home, irrigation, municipal, industrial)

WELL COMPLETION DATA:


- (1) diameter (inches) 4"
- (2) total depth (feet) 1200
- (3) static water level (feet) 200 below top of ground
- (4) casing plastic 1100  
(material) (depth)  
4" if telescope see back.  
(size)
- (5) screen 100 1100  
(length) (depth to top)  
4" plastic  
(size) (material)
- (6) pump 1/2 hp 10  
(HP) (yield gpm)  
elec.  
(type power)
- (7) electric log                       
(yes or no)  
                      
(organization running log)
- (8) how well bottom plugged B.W.O.

DRILLERS REMARKS:  
Salvage pipe

MISS. Bd. of Water Comm. 11/31/75

If well telescopes please sketch and show depths.

GROUND LEVEL

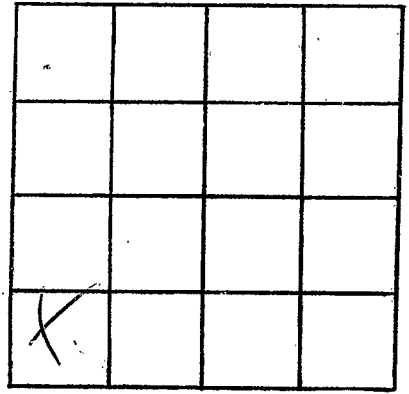

SECTION \_\_\_\_\_

Please indicate well location X.

ADDITIONAL INFORMATION

A series of horizontal lines for writing additional information.

If more than one screen, show locations of each on sketch.