

WALTHALL
H 70

3-23-76

MISSISSIPPI
BOARD OF WATER COMMISSIONERS
416 North State Street
Jackson, Mississippi 39201

CODED

WATER WELL DRILLERS LOG

3-23

1976 R. Woodward Drilling

WALTHALL

date well completed

firm name

county well located

LANDOWNER: J. W. STAFFORD

RT. 6

TyleATOWN, Miss.
(mailing address)

WELL LOCATION:

sec. 17 T. 1 N R. 10 E

6 miles SW of Lexie
(distance) (direction) (nearest town)

WELL PURPOSE: Home
(home, irrigation, municipal, industrial)

WELL COMPLETION DATA:

(1) diameter (inches) 2

(2) total depth (feet) 189'

(3) static water level (feet) 12 above
top of ground.

(4) casing 2" PVC 100'
(material) (depth)

(size) If telescope see back.

(5) screen NONE
(length) (depth to top)

(size) (material)

(6) pump 125 GPM
(HP) (yield gpm)

(type power)

(7) electric log No
(yes or no)

(organization running log)

(8) how well bottom plugged

description of formations
encountered

from

to

Clay gravel 0 6'

Gravel 6' 18'

White Clay 18 30'

gray sand 30' 82'

Blue Clay 82' 115'

Fine sand 115 158

Good sand 158 189'

DISCONTINUED


MAR 5 1976

MISS. BD. OF W.

DRILLERS REMARKS:

If well telescopes please sketch and show depths.

GROUND LEVEL

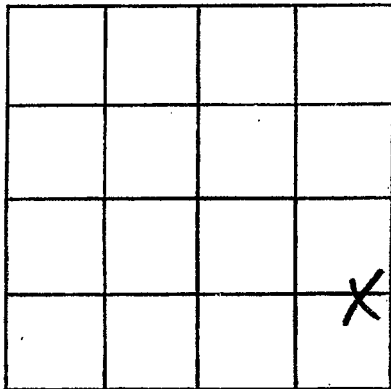

SECTION 17

Please indicate well location X.

ADDITIONAL INFORMATION

If more than one screen, show locations of each on sketch.