

MISSISSIPPI DEPARTMENT OF NATURAL RESOURCES

Bureau of Land and Water Resources

Southport Mall

P.O. Box 10631

Jackson, Mississippi 39209

CODED

WATER WELL DRILLERS LOG

Walthall
H 77
4-8-86


4-8 1986 Fitzgerald Well Serv Walthall
date well completed firm name county well located

LANDOWNER:	description of formations encountered	from	to
<u>Charles Toth</u>	<u>Reel Clay</u>	<u>0</u>	<u>20</u>
<u>R.R. Lybourn, Jr.</u> (mailing address)	<u>Reel Sand</u>	<u>20</u>	<u>80</u>
WELL LOCATION: sec. <u>10</u> T <u>1</u> N R <u>10</u> E S W	<u>Coarse sand + gravel</u>	<u>80</u>	<u>150</u>
<u>1</u> miles <u>S</u> of <u>Leake</u> (distance) (direction) (nearest town)	<u>+ 7 sand rods</u>		
WELL PURPOSE: <u>Home</u> (home, irrigation, municipal, industrial)			
WELL COMPLETION DATA:			
(1) diameter (inches) <u>4</u>			
(2) total depth (feet) <u>150</u>			
(3) static water level (feet) <u>40</u> below top of ground. above			
(4) casing <u>PVC</u> <u>120</u> (material) (depth) <u>4</u> (size) if telescope see back.			
(5) screen <u>30</u> <u>120</u> (length) (depth to top) <u>4</u> <u>PVC</u> (size) (material)			
(6) pump <u>5</u> <u>99</u> (HP) (yield gpm) <u>Elec</u> (type power)			
(7) electric log <u>No</u> (yes or no)			
(organization running log)			
(8) how well bottom plugged <u>Sand</u>			
DRILLERS REMARKS:			

MISSISSIPPI DEPARTMENT OF NATURAL RESOURCES
MAY 5 1986
BUREAU OF LAND AND WATER RESOURCES

If well telescopes please sketch and show depths.

GROUND LEVEL

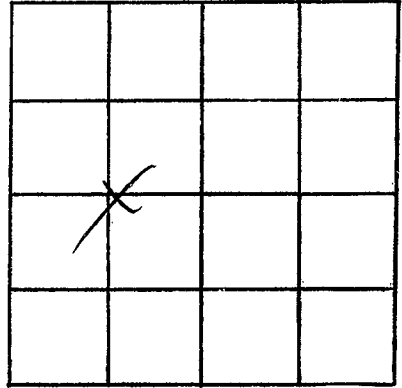

SECTION 10

Please indicate well location X.

ADDITIONAL INFORMATION

If more than one screen,
show locations of each on sketch.