

MISSISSIPPI DEPARTMENT OF NATURAL RESOURCES

Bureau of Land and Water Resources

Southport Mall

P.O. Box 10631

Jackson, Mississippi 39209


WATER WELL DRILLERS LOG

Walthall  
#79

CODED:

1-23-94 19 Amitie Pump + well WALTHALL  
date well completed license # 0-235 firm name county well located

LANDOWNER: <u>Jerry Rayborn</u> <u>30481 Hwy 25</u> <u>Franklinton, La</u> (mailing address) <u>70438</u>	description of formations encountered	from	to
WELL LOCATION: sec. <u>34</u> T. <u>1</u> (N) S. R. <u>10</u> (E) W. <u>1/4</u> miles (distance) <u>state line</u> (direction) of <u>10</u> (nearest town)			
WELL PURPOSE: <u>Irrigation</u> (home, irrigation, municipal, industrial)	clay	0	5
WELL COMPLETION DATA: (1) diameter (inches) <u>7 1/2" 4"</u>	gravel	5	42
(2) total depth (feet) <u>380'</u>	clay	42	60
(3) static water level (feet) <u>Flow</u> below above top of ground.	clay + sand	60	80
(4) casing <u>Sch 40 PVC</u> (material) <u>350'</u> (depth)	sand + pea gravel	80	200
<u>4"</u> (size) if telescope see back.	clay + sand	200	260
(5) screen <u>30' #8</u> (length) <u>380' - 350'</u> (depth to top)	sand	260	270
<u>4"</u> (size) <u>Sch 40 PVC</u> (material)	sand + clay	270	320
(6) pump <u>Flow</u> (HP) <u>90</u> (yield gpm)	sand + pea gravel	320	380
(7) electric log <u>NO</u> (yes or no)			
(organization running log)			
(8) how well bottom plugged <u>N/A</u>			
DRILLERS REMARKS:			

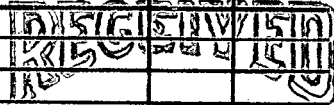


FEB 25 1994

Dept. of Environmental Quality  
Office of Land & Water Resources

If well telescopes please sketch and show depths.

GROUND LEVEL

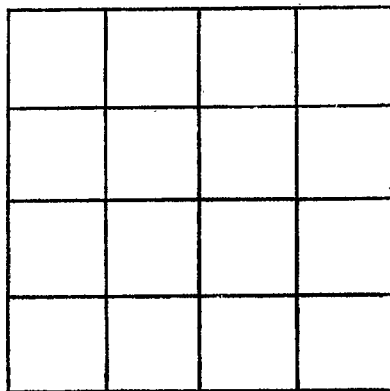

SECTION \_\_\_\_\_

Please indicate well location X.

ADDITIONAL INFORMATION

If more than one screen, show locations of each on sketch.