

MISSISSIPPI DEPARTMENT OF NATURAL RESOURCES

Bureau of Land and Water Resources

Southport Mall

P.O. Box 10631

Jackson, Mississippi 39209

WATER WELL DRILLERS LOG

WALTHALL
H 81

CODED

1-29-94 19 Amite Pump + well WALTHALL
date well completed license # 0-235 firm name county well located

LANDOWNER:	description of formations encountered	from	to
Jerry Rayborn 30481 Hwy 25 Franklinton, LA (mailing address) 70438	clay	0	5
	gravel	5	42
	clay	42	60
	clay + sand	60	80
	sand + pea gravel	80	200
	clay + sand	200	260
	sand	260	270
	clay + sand	270	320
	sand + pea gravel	320	370
WELL LOCATION:			
sec. <u>34</u> T- <u>1</u> (N) R- <u>10</u> (E) S W			
<u>1/4</u> miles <u>State Line</u> (distance) (direction) (nearest town)			
WELL PURPOSE: <u>irrigation</u> (home, irrigation, municipal, industrial)			
WELL COMPLETION DATA:			
(1) diameter (inches) <u>7 1/2</u> <u>4"</u>			
(2) total depth (feet) <u>370'</u>			
(3) static water level (feet) <u>Flow</u> below above top of ground.			
(4) casing <u>Sch 40 Pvc</u> , <u>340'</u> (material) (depth)			
<u>4</u> (size) if telescope see back.			
(5) screen <u>30' #8</u> , <u>370' - 340'</u> (length) (depth to top)			
<u>4</u> , <u>Sch 40 PVC</u> (size) (material)			
(6) pump <u>Flow</u> <u>100</u> (HP) (yield gpm)			
<u>None</u> (type power)			
(7) electric log <u>NO</u> (yes or no)			
<u></u> (organization running log)			
(8) how well bottom plugged <u>N/A</u>			
DRILLERS REMARKS:			


RECEIVED

FEB 25 1994

Dept. of Environmental Quality
Office of Land & Water Resources

If well telescopes please sketch and show depths.

GROUND LEVEL

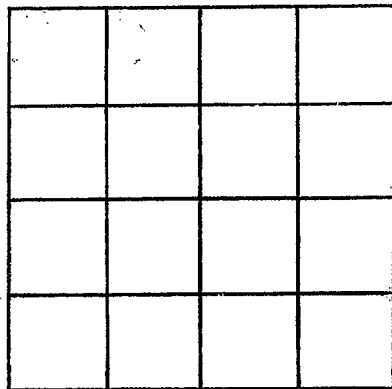

SECTION _____

Please indicate well location X.

ADDITIONAL INFORMATION

If more than one screen,
show locations of each on sketch.