

MISSISSIPPI DEPARTMENT OF ENVIRONMENTAL QUALITY

Office of Land and Water Resources

P. O. Box 10631
Jackson, MS 39289-0631
WATER WELL DRILLERS LOG

COUNTY WELL LOCATED
Walton

WELL NUMBER
H-88

DATE WELL COMPLETED
3-24-03

PERMIT NUMBER

NAME OF DRILLING FIRM
F. Fitzgerald Well Sewer

NAME & MAILING ADDRESS OF LANDOWNER
Maigre Loop
Brockdale Rd.

Latitude:
Longitude:

WELL LOCATION. SEC 24 TOWNSHIP 1 RANGE 10 N S E W

DISTANCE 10 Miles DIRECTION SW of NEAREST TOWN Tylerwood

OTHER LANDMARK

WELL PURPOSE: Home, Irrigation, Municipal, Industrial, Fish Pond, etc.

PUMP DATA

PUMP TYPE (Circle One):
 Submersible, Turbine, Jet, Flowing Well,
Other (Describe)

POWER TYPE (Circle One):
 electric, Tractor, Diesel, Gasoline, Butane,
Other (Describe) H/P 3/4

DESCRIPTION OF FORMATIONS ENCOUNTERED	FROM	TO
<u>clay</u>	<u>0</u>	<u>20</u>
<u>sand</u>	<u>20</u>	<u>40</u>
<u>clay</u>	<u>40</u>	<u>50</u>
<u>gravel</u>	<u>50</u>	<u>80</u>
<u>course sand</u>	<u>80</u>	<u>95</u>

RECEIVED
APR 29 2003
BY: OLWR

Top of Lap Pipe or Reduction in Casing

FEET	IF TELESKOPED OR MORE THAN ONE SCREEN: USE BACK PAGE
------	--

WELL DATA

Well Depth <u>95</u>	Casing Diameter (In.) <u>4"</u>	Casing Length (Ft.) <u>85</u>
Type of Casing <u>pvc</u>	Hole Depth <u>95'</u>	Depth to Static Water Level <u>75'</u>

TYPE OF COMPLETION: (Circle One or More):
 Gravel Packed, Underreamed, Telescoped,
 Natural Development, Open Hole, Other
(Describe)

WELL GROUTED TO A DEPTH OF 10 FEET
Type Grout (circle one): Cement, Bentonite, Mix

SCREEN DATA

Diameter - Inches <u>4"</u>	Length - Feet <u>10'</u>	Slot Size - Inches <u>.012</u>
Screen Type <u>pvc</u>	Depth to Bottom - Feet <u>95'</u>	


I certify that the well was drilled, constructed and completed in accordance with all applicable Requirements of the Mississippi Department of Environmental Quality and/or the Mississippi Department of Health regulations and state laws.

Beal Fitzgerald 029
Signature of Licensed Driller and License No.

4-24-03
Date

If well telescopes please sketch and show depths.

GROUND LEVEL

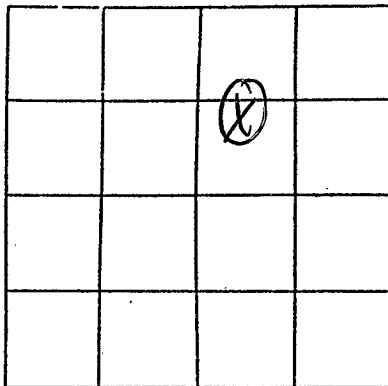

SECTION 29

Please indicate well location X.

Pump Capacity (GPM)	No. of Stages	Setting Depth	
12	12	85'	FT.

PUMP TEST

Well yielded _____ GPM with
a drawdown of _____ ft.
after _____ hours of pumping

LOG DATA

TYPE OF LOG RUN (Circle One): No Log Run, Electric, Gamma Ray, Density, Sonic, Neutron, Other (Describe) _____

Name of Organization Running Log _____

GEOLOGIC DATA (Office Use Only)

Surface Elev.	Geologic Unit	Unit Thickness	Depth to Top
Subs. SWL	Date	Analysis	Aquifer Test

Driller's Remarks

If more than one screen, show location of each on sketch.