

State Well Report

Part 1 - Driller's Log

Mississippi Department of Environmental Quality
Office of Land and Water Resources
P.O. Box 10631
Jackson, MS 39289-0631
(601)961-5210
(601)354-6938 (fax)

For Office Use Only:

Aquifer: _____
Well #: **H-103**
L. S. Elevation: _____
E-log #: _____

County: **Waltham**
Permit #: _____
Driller: **Fitzgerald Well Service**
Date drilling completed: **5-19-05**

State Law requires that this report be prepared by the license holder responsible for the work and filed with the Department at the above address within 30 days of completion of drilling of the well or borehole.

Information on Well Owner (Landowner if borehole is not for a water well)	Well or Borehole Location
Owner Name: HENRY HENRY Duncan	Latitude: _____ Longitude: _____
Mailing Address: Old River Rd	Method of Lat/Long (circle one): Conventional Survey
Tylertown MS	USGS quad, Hand-held GPS, Survey-grade GPS
City State Zip Code	_____ 1/4 _____ 1/4 Sec 1 Twn 1N Rng 10E
Telephone No. (____)	Distance 7 Miles Direction SU of Nearest Town Tylertown

Well / Borehole Data

Date drilling started **5-19-05** Date drilling completed **5-19-05** Hole depth: **97'** Hole diameter: **8"**

Location of the source of any surface water used for drilling: _____
Method of dosing and volume of Chlorine used in drilling and development: _____

Logs run (circle all applicable): No log run Electric Gamma Ray Density Sonic Neutron Other: _____
Name of organization running log(s): _____

Purpose of borehole (check one): Water Well Geotechnical Geological Investigation _____ Ground Source Heat Pump _____
Seismic Survey _____ Other (describe) _____

If drilling is not related to water well construction, skip the remainder of this block

Purpose of Well (check one): Home Industrial _____ Public Supply _____ Irrigation _____ Fish Culture _____ Other: _____

If a flowing well, method of flow regulation: Valve _____ Other (describe) _____

Static Water Level: **53'** feet above or below (circle one) land surface Date measured: **5-19-05**

Method of Measurement (circle one) steel tape electric tape air line other: _____

Well depth: **97'** Well grouted to a depth of **10** feet Type of grout (circle one): Neat Cement Bentonite Mix

Casing length: **87'** feet Casing diameter: **4"** inches Type of casing: **PVC**

Screen length: **10'** feet Screen diameter: **4"** inches Type of screen: **PVC**

Screen slot size: **.012** inches Setting depth: From **87'** feet to **97'** feet

Type of completion (circle all applicable): gravel packed Underreamed Telescoped Open hole Natural Development
Other (describe): _____

Top of lap pipe or reduction in casing: _____ feet. **If telescoped or more than one screen, describe on next page**

Form: OLWR-SWR-1A

RECEIVED

JUN 02 2005

BY: OLWR

RECEIVED

JUN 02 2005


BY: OLWR

H-103

The sketch below only required for water wells


If well telescopes, show depths on sketch.

Description of formations encountered must be provided for all wells and boreholes, unless specifically exempted by regulations

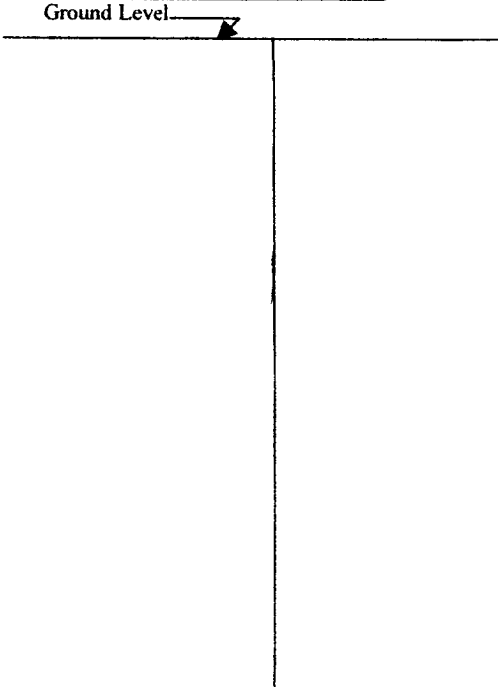

Description of Formations Encountered	From (depth) Ground Level	To (depth)
clay	0	20
shale	20	60
clay	60	70
sand	70	80
large sand & gravel	80	97

If more than one screen, show location of each on sketch

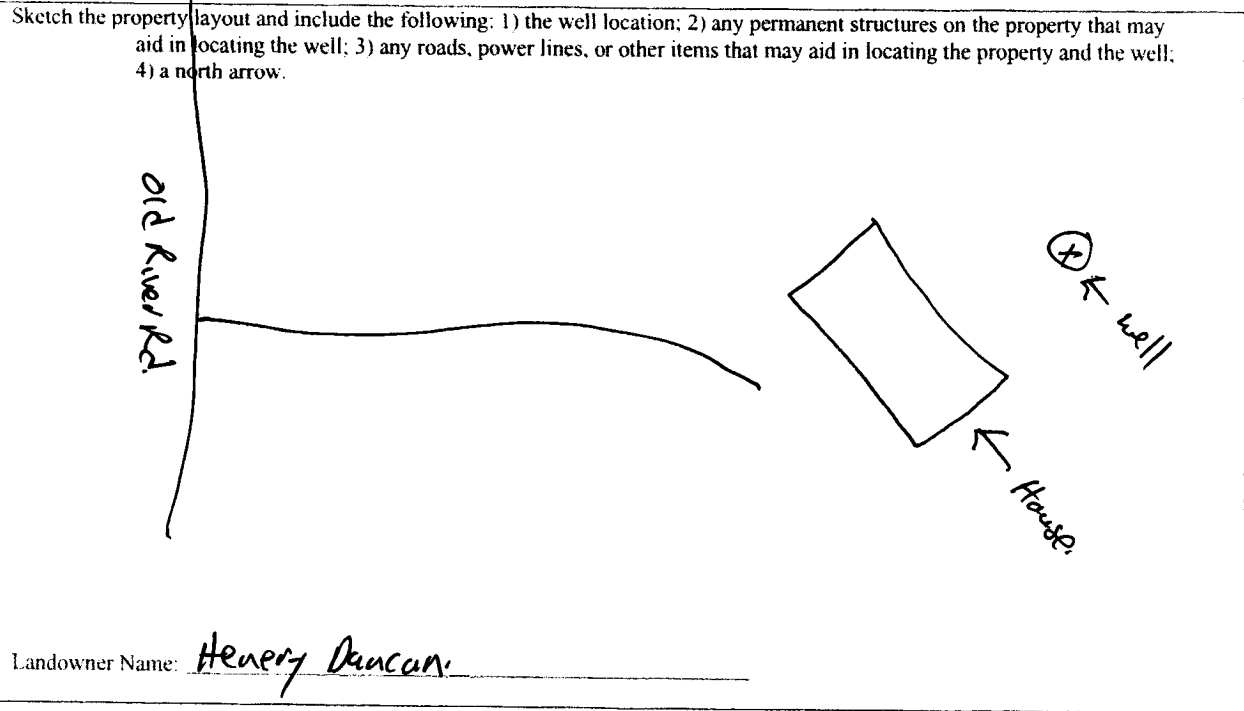

Form: OLWR-SWR-1A

I certify that the well/borehole was drilled, constructed, and completed in accordance with all applicable requirements of the Mississippi Department of Environmental Quality and the Mississippi Department of Health regulations, if applicable, and state laws.

BAD Fitzgerald 029 5-19-05 BAD Fitzgerald
 Print Name of Responsible Licensee and License No. Date Signature of Licensee

RECEIVED
 JUN 02 2005
 BY: OLWR

STATE WELL REPORT

Part 2

Pump Installer's Completion Report
 Mississippi Department of Environmental Quality
 Office of Land and Water Resources
 P.O. Box 10631
 Jackson, MS 39289-0631
 (601)961-5210
 (601)354-6938 (fax)

County: Waltham
 Permit #: _____
 Driller: Fitzgerald Well Serv.
 Date completed: 5-19-05
Copy information from block on Part 1

For Office Use Only:

Aquifer: _____
 Well #: H-103
 Elevation: _____

This part of the report must be completed by a licensed water well contractor or a licensed pump installer. A copy of Part 1 of the report must be attached and both parts filed with the Department at the above address within 30 days of well completion.

Well Owner Information	Well Location
Owner Name: <u>Heary Duncan</u>	Latitude: _____ Longitude: _____
Mailing Address: <u>Old River Rd</u>	Method of Lat/Long (check one): Conventional Survey _____
<u>Tylertown MS</u>	USGS quad _____ Hand-held GPS _____ Survey-grade GPS _____
City State Zip Code	_____ 1/4 _____ 1/4 Sec <u>1</u> T <u>1N</u> R <u>10E</u>
Telephone No. (____) _____	Distance Direction Nearest Town
	<u>7</u> Miles <u>SW</u> of <u>Tylertown</u>

Pump Type Circle one	Power Type Circle one
Air Lift Jet <input checked="" type="radio"/> Submersible	Diesel Engine Gasoline Engine Natural Gas
Bucket Piston Turbine	<input checked="" type="radio"/> Electric Motor Hand Tractor PTO
Centrifugal Rotary Flowing Well	Windmill Other (specify): _____
Other (specify): _____	Horse Power Rating of Motor: <u>1/2</u>
Date Pump Installed: <u>5-19-05</u>	Setting Depth: <u>85</u> feet
Rated Pump Capacity: <u>12</u> Gallons Per Minute	Number of Stages: <u>8</u>

Pump Test Data	Method of Measuring Water Level Circle one
Date Well Tested: _____	Air Line Electric Measuring Line <input checked="" type="radio"/> Steel Tape
Static Water Level (A): _____ Feet Below Land Surface	Other (specify): _____
Pumping Water Level (B): _____ Feet Below Land Surface	For flowing well, measured shut in head: _____ feet
Drawdown [(B) - (A)]: _____ Feet Below Land Surface	Well yielded _____ GPM with a drawdown of _____ feet after _____ hours of pumping
Test Pumping Rate: _____ Gallons Per Minute	
Duration of Pump Test (minimum 4 hours): _____ hours	

I HEREBY CERTIFY that the above statements are true to the best of my knowledge.

Brad Fitzgerald 029 Beard Fitzgerald
 Print Name of Pump Installer and License No. (if applicable) Signature of Pump Installer

Form: OLWR-SWR-1B

RECEIVED
 JUN 02 2005
 BY: OLWR