

WALTHALL MISSISSIPPI BOARD OF WATER COMMISSIONERS

~~2-10-63~~ H<sup>2000</sup>  
2-10-63

WATER WELL DRILLERS LOG


Date: 2-10, 1963, Driller: E. B. SHEPPARD County Walthall  
(Name)

(1) Owner of Land: Vera D. Lee Williams  
(Name)  
Rt. 2 - Tylertown, Miss  
(Address)  
(2) Location: 1 1-10  
3 miles S.E., of TYLERTOWN  
(distance) (direction) (Nearest Town)  
(3) Topography:  (Hilly)  (Flat)  (Level)  
(4) Purpose of Well: Domestic  
(Domestic Irrigation  
Municipal, Industrial, Other)

Description & Color of Materials Sand, Clay, Red Clay, Shell, etc.	Thick- ness Feet	Depth Feet
RED SANDY CLAY		20
GRAY SANDY CLAY		40
SOFT GRAY CLAY		80
<del>ON GRANULAR SAND</del>		<del>100</del>
		120

Information upon completion of well:

(1) Diameter 2 inches.  
(2) Total Depth 103 feet.  
(3) Water Level 70 feet below top of ground.  
(4) Cased to \_\_\_\_\_, Size \_\_\_\_\_  
(5) Screen: Size 2", Length 5'  
(6) Were any formations sealed against pollution?  
\_\_\_\_\_ yes, \_\_\_\_\_ no.

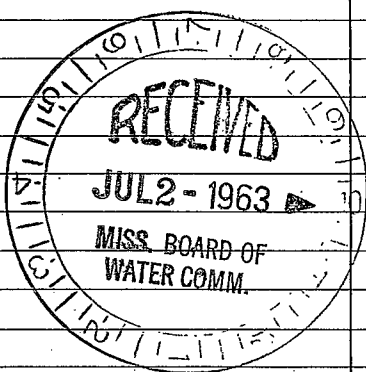

If YES depth of formation \_\_\_\_\_  
Why \_\_\_\_\_  
Drillers Remarks: \_\_\_\_\_

Well No.

(Use Back Side)

