

5-13-64

WATER WELL DRILLERS LOG

Date: 5-13, 1964, Driller: Ralph L. Reeves County: Walthall  
 (Name)

(1) Owner of Land: J.E. Prescott  
 (Name)  
RFD - Tyler town N.  
 (Address)  
2 IN 10 E  
 (2) Location: 1/4, 1/4, Sec. T R  
4 miles EAST of Princeton  
 (distance) (direction) (Nearest Town)  
 (3) Topography: Hilly  
 (Hilly) (Flat) (Level)  
 (4) Purpose of Well: Domestic  
 (Domestic Irrigation  
 Municipal, Industrial, Other)


Description & Color of Materials Sand, Clay, Red Clay, Shell, etc.	Thick- ness Feet	Depth Feet
<u>clay</u>	<u>20</u>	<u>20</u>
<u>sand, clay</u>	<u>30</u>	<u>50</u>
<u>sand gravel</u>	<u>10</u>	<u>60</u>
<u>clay gravel</u>	<u>5</u>	<u>65</u>
<u>Gravel &amp; sand</u>	<u>7</u>	<u>72</u>

Information upon completion of well:

(1) Diameter 4 inches.  
 (2) Total Depth 72 feet.  
 (3) Water Level 50 feet below top of ground.  
 (4) Cased to Bottom, Size 4"  
 (5) Screen: Size 4", Length 7"  
 (6) Were any formations sealed against pollution?  
 \_\_\_\_\_ yes,  no.

If YES depth of formation \_\_\_\_\_  
 Why \_\_\_\_\_

Drillers Remarks: old well  
Bad -

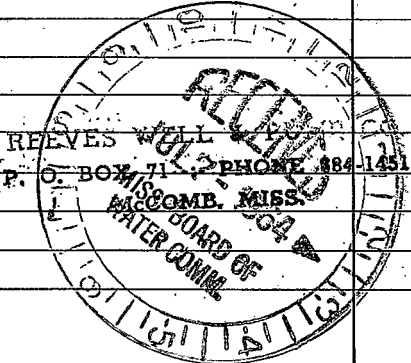

(Use Back Side)

Well No.

1950

1951

1952

1953

1954

1955