

Wathall
 H 2003
 12-10-75

MISSISSIPPI
 BOARD OF WATER COMMISSIONERS
 416 North State Street
 Jackson, Mississippi 39201

WATER WELL DRILLERS LOG

12-10 date well completed 19 75 Fitzgerald Well Serv firm name Wathall county well located

LANDOWNER:
 Jack Copeland
 R.R. 1 (mailing address)

description of formations encountered	from	to
Red Clay	0	20
Red Sand	20	80
White Chalk	80	125
Coarse Sand gravel	125	138

WELL LOCATION:
 sec. 25 T 1 N R 9 E
 S W
 6 miles E of Progress (distance) (direction) (nearest town)

WELL PURPOSE: Home (home, irrigation, municipal, industrial)


- WELL COMPLETION DATA:
- (1) diameter (inches) 4
 - (2) total depth (feet) 138
 - (3) static water level (feet) 75 below top of ground.
 - (4) casing PVC, 130 (material) (depth)
 4 (size) if telescope see back.
 - (5) screen 8, 130 (length) (depth to top)
 4, PVC (size) (material)
 - (6) pump 1/2, 10 (HP) (yield gpm)
 Elec (type power)
 - (7) electric log No (yes or no)
 (organization running log)
 - (8) how well bottom plugged sandstone

DRILLERS REMARKS:

MISSISSIPPI BOARD OF WATER COMMISSIONERS
 DEC 17 1975
 MISS. BO. OF WATER COMMISSIONERS

If well telescopes please sketch and show depths.

GROUND LEVEL

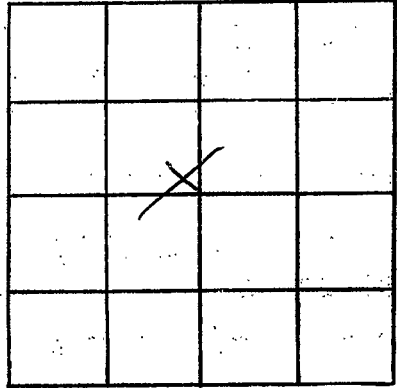

SECTION 25

Please indicate well location X.

ADDITIONAL INFORMATION

If more than one screen, show locations of each on sketch.