

WALTHALL  
H 2005  
7/28/76

MISSISSIPPI  
BOARD OF WATER COMMISSIONERS  
416 North State Street  
Jackson, Mississippi 39201

WATER WELL DRILLERS LOG

7-28  
date well completed

1976 *Fitzgibbon*  
firm name

Walthall  
county well located

LANDOWNER:

*Sedric Brock*

*R.R. Fyfe*  
(mailing address)

WELL LOCATION:

sec. 31 T. 1 N. R. 10 E.  
S W  
11 miles S of Fyfe  
(distance) (direction) (nearest town)

WELL PURPOSE: Home  
(home, irrigation, municipal, industrial)

WELL COMPLETION DATA:

- (1) diameter (inches) 4
- (2) total depth (feet) 134
- (3) static water level (feet) 50 below above top of ground.
- (4) casing PVC, 126,  
(material) (depth)  
4 if telescope see back.  
(size)
- (5) screen 8, 126  
(length) (depth to top)  
4, PVC  
(size) (material)
- (6) pump 3/4, 15  
(HP) (yield gpm)  
Electric  
(type power)
- (7) electric log No  
(yes or no)  
(organization running log)
- (8) how well bottom plugged Sand block

description of formations encountered

from to

<i>Red clay</i>	0	20
<i>Red sand</i>	20	90
<i>Red gravel</i>	90	100
<i>Red sand</i>	100	120
<i>Coarse sand &amp; gravel</i>	120	134

DRILLERS REMARKS:


RECEIVED

AUG 20 1976

MISS. BD. OF WATER COMM

If well telescopes please sketch and show depths.

GROUND LEVEL

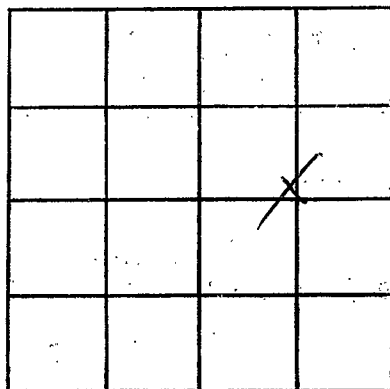

SECTION 31

Please indicate well location X.

ADDITIONAL INFORMATION

If more than one screen, show locations of each on sketch.