

WALTHALL
 H 2000
 9/24/76

MISSISSIPPI
 BOARD OF WATER COMMISSIONERS
 416 North State Street
 Jackson, Mississippi 39201

WATER WELL DRILLERS LOG

Sept. 24 1976 Staffer Well Dr. Walthall
 date well completed firm name county well located

LANDOWNER Jimmy Boyd
St. 6
Iyletown, Miss
 (mailing address)

WELL LOCATION:
 sec. 18 T. 1 (N) R. 10 (E)
7 miles SW of Iyletown
 (distance) (direction) (nearest town)

WELL PURPOSE: none
 (home, irrigation, municipal, industrial)

WELL COMPLETION DATA:
 (1) diameter (inches) 4"
 (2) total depth (feet) 115
 (3) static water level (feet) _____ below above top of ground.
 (4) casing plastic 105
 (material) (depth)
4" If telescope see back.
 (size)
 (5) screen 105 105
 (length) (depth to top)
4" plastic
 (size) (material)
 (6) pump 1/2 hp _____
 (HP) (yield gpm)
elect
 (type power)
 (7) electric log _____
 (yes or no)
 (organization running log)
 (8) how well bottom plugged BWD


description of formations encountered	from	to
top soil	0	2
s.s. & gravel	2	30
gravel	30	90
sand	90	115

DRILLERS REMARKS:
[Signature]

RECEIVED
 OCT - 2 1976
 MISS. DE. OF WATER COM. M

If well telescopes please sketch and show depths.

GROUND LEVEL

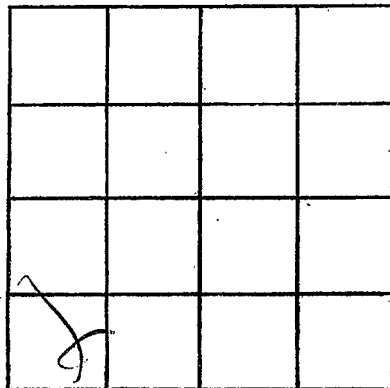

SECTION _____

Please indicate well location X.

ADDITIONAL INFORMATION

If more than one screen,
show locations of each on sketch.